

JAMES B. GLASCOCK, ARCHITECT P.C.

ARCHITECTURE & PLANNING

[REDACTED]
[REDACTED]
[REDACTED]
e-mail: glascock@mtcon.net

July 25, 2017

Salt Lake Costume Project
1701 South 1100 East
Salt Lake City, Utah 84120

Planned Development Application

Request - Revised

1. Permit the Allowable Parapet Height and Roof to be 5'-0" above the permitted height in the RB Zone from 30' above Finished Grade to 35'-0" above existing grade. The Existing Top of Parapet and Top of Building is currently at 33'-6" above finished grade and the current plans show the New Top of Parapet and Top of Bldg is the same at 33'-6". This would allow the Architect and Structural Engineer to adjust the final heights of the roof and floors as needed to resolve some complex existing and unknown connection heights to the existing building bearing walls. The intent would be to finish the building within the 33'-6" but allows the architect some flexibility during the remodel stage.
2. The Existing Iconic and Historical "Knight" sign on the Northwest Building Corner is intended to Remain in Place and will ***not*** be moved, extended, altered or changed in any way. The Existing Sign is in good shape and has relatively no deterioration. The only corrections would be to Re-Paint the sign to Match the Existing Colors and to Re-pair any current Structural Connections to ensure the safety of the Existing Sign and Existing Front Canopy. We will modify the Existing Canopy with new roofing, edge cap and paint. This will preserve one of the most known Icons in the Sugarhouse Area
3. Permit the Use of new historic type "Water Towers" on the roof to replace the Existing Metal Cell Towers. There are three (3) Existing Cell Towers and our plan is to replace the three with two (2) New Water Towers for the cell service equipment. The Three Existing Cell Towers are 9 FT High above the roof parapet x 10 FT wide x 10 FT deep. Two are very close to the roof edge and can easily be seen at street level. Our Proposed Water Towers are centered in the middle of the roof east to west and set back 1/3 the length of the roof from the north and south roof edges. They would only be seen from a distance. Attached are some photos that show the existing cell towers from the street level, roof level and Birdseye level for clarity.
4. The zoning code will only allow the decorative balconies and planters on 1700 South and 1100 East to extend only 4" from the new building face. We would request that these items be allowed to extend to 12" from the building face for better architectural definition. The site plan is at such a scale that you won't see the 12" extension clearly. The Existing Elevations show the 4" required depth on the North (1700 South) and West (1100 East) to meet zoning requirements. The other two elevations are shown at 12" from the building face since they are not within the minimum setbacks required. I have attached Sheet A-3.1, Third Floor plan which shows the 4" balconies on the north and west. Grids A and 1 are the face of the existing foundation. It is important to note that neither the requested 12" deep balconies nor the 12" deep planters on 1100 East or 1700 South will extend over the property line at any point. They will extend 8" further into the setbacks on those two streets 8" further than is allowed by code.

Project Description- Revised

The current structure has been vacant for nearly 12 years and without some relief will remain vacant until some developer purchases the property as a tear down. Under the current RO setbacks, this would only allow a Convenience Store, Gas Station or Fast Food, which is not in the interests of what is a Prime Gateway Entry to the Westminster and Sugarhouse Area. The south half of the building was original constructed in the late 1800's as a lumberyard building. Later it was obtained by Westminster College and a new north end was constructed as their Chapel with many decorative features, such as twin bell towers with stained glass on the north end and connected to the lumberyard building. Sometime around WW II, the building was converted to the Costume Company with at least two additions and two floors added. The additions were constructed with non-descript non-matching brick and concrete block and the bell towers were re-configured into an elevator and storage and the distinctive bell tower features removed. The walls were left as new brick and the original building was covered with a hard non-removable stucco. At least the Iconic "Knight" sign was added to give the structure some design. After the Costume Company went out of business, an interior design and kitchen cabinet business took over and added the black awnings to further degrade the building. After they went out of business, the structure has sat vacant with no improvements made. There is a very tall evergreen tree barrier that was installed at some time at the east parking lot and remains as a significant visual and sound barrier and we would maintain this barrier to protect the adjacent homeowners to the east. There have been a half-dozen recent design attempts to remodel the building but all have been architecture that adds nothing to the flavor the Neighborhood deserves, all being very modern in design.

Our proposed use would be to create an apartment building that would create a vision of what historically should be done with all new buildings that act as a Gateway to the Westminster and Sugarhouse Area. We have researched structures built at the turn of the century through the 1920's in Salt Lake, Chicago and New York in gentrified areas. We want to combine this sense of historical flavor with our proposed new development that addresses the growing need for urban living for the selective millennial population. It is our intent to provide a residential and live work opportunity to meet the demand for a downtown lifestyle in the Sugar House area. With expansive ceilings, state of the art appliances, yet a 1920's vintage look, we will provide quaint living in the heart of Salt Lake's emerging most sought after neighborhood. We will add an antique distressed brick veneer to all facades (existing and new) to cover the existing surfaces, add steel elements indicative of architecture of that period, add historical elements to the façade such as the flags and balconies, especially the Iconic "Knight" sign and roof elements such as the water towers that enhance and strengthen our design concept. We will meet all building, fire, zoning and engineering requirements and will bring new life to a building that needs architectural attention. We have added a significant amount of glass at the pedestrian street level for additional softening of the building at eye level. We believe strongly that our somewhat modified "historical" design approach is what the master planning for the Sugarhouse area intended and that our building will provide a significant architecture feature to what is an immensely important "Gateway" entrance to Sugarhouse and would serve as a design guideline for future new and remodeled buildings in the area.

Planned Development Information

The following will be an item by item response to the criteria in the application:

- a. The proposed existing building remodel and additions will follow the same building setbacks and current parapet of the existing. The remodeled building and addition will create a design of architecture up to 1920 period. The existing building and new additions will be finished with a distressed brick veneer to mimic the brick used and aged from that period. We have added numerous architectural features that take the building from a commercial/ light industrial "plain jane" look to an exciting historical residential feel that will enhance the surrounding neighborhood. We have added period historical elements such as balconies, flags, water towers to mask the cell towers, steel arch elements and stone base and wainscot to continue our theme. We would want to keep and re-furbish the Iconic "Knight" Sign as a historical feature well known in the Salt lake Environs.
- b. We will keep the site slopes as they exist and minimize the land reshaping. We will keep and maintain the tall evergreen tree barrier that was installed at some time at the east parking lot and it will remain as a significant visual and sound barrier.
- c. Although this building has undergone numerous remodels and additions, most that have negatively affected the building, it is still an important element in the neighborhood fabric. Many Salt Lake Residents have memories of this building both as a chapel and the best costume rental business. I remember coming to the building in 1955 to be fitted for a costume for school ceremony. The "Knight" sign is historically significant and needs to be saved and kept for future generations of a sign of past times. Our plan recognizes the importance of the building and its place in the neighborhood.
- d. The building design with period brick veneer, glazing at the pedestrian level, the addition of historical architectural elements, maintaining the existing east evergreen barrier, the work-live element to the building, adding residents, all add to a better visual experience and environment to the neighborhood. This is significantly light years better than the obvious other probable uses of a Convenience Store, Gas Station or Fast Food Establishment.
- e. We have already enumerated the many special design amenities that would be of interest to the general public. Please refer to Items #a, c and d above.
- f. We will eliminate the existing blighted structure, but not by removing it and replacing it, but by rehabilitation through remodeling and adding to it. We believe that tearing down an old building is against the belief that we should maintain our history and preserve it.
- g. We will provide 19 new housing or apartment units that will be rented at market rates.
- h. We are planning on using many green building techniques. First and foremost, we are not tearing the building down, but building onto the existing structure and not wasting materials. We are moving one existing wood floor down and the existing wood roof up to re-use existing building materials. Any wood and brick materials that are demolished will be re-used wherever possible to minimize materials going to waste. All new materials used are "green" and re-useable such as brick, steel, concrete block, wood, concrete and new apartment units will use bamboo floors and energy star rated appliances.

James B. Glascock, Architect




Google Maps 1089 E 1700 S



Image capture: May 2016 © 2017 Google United States

Salt Lake City, Utah

Street View - May 2016

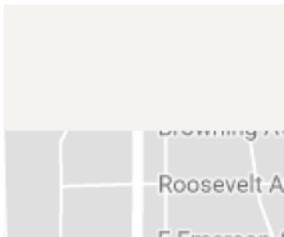









REMODEL PLANS

FOR: SALT LAKE COSTUME BUILDING 1701 SOUTH 1100 EAST SALT LAKE CITY, UTAH 84120

ARCHITECT PROJECT #15-027

DATE: FEBRUARY 03, 2017 - ORIGINAL PERMIT REVIEW SET

DATE: APRIL 04, 2017 -REVISED PERMIT REVIEW AND BID SET

04-05-17 - SLC DEPT PLAN REVIEW AND OWNER VALUE ENGINEERING CORRECTIONS

OWNER

SALT LAKE COSTUME PROPERTIES, INC

CONTACT: JAMES HARDY

1706 SOUTH 500 WEST

BOUNTIFUL, UTAH 84010

OFFICE PHONE (801) 975-0222

EMAIL: JAMES@JLHARDY.COM

GENERAL CONTRACTOR

JL HARDY CONSTRUCTION, INC.

UTAH STATE CONTRACTORS LICENSE: 252733-5501

CONTACT: JAMES HARDY

1706 SOUTH 500 WEST

BOUNTIFUL, UTAH 84010

OFFICE PHONE (801) 975-0222

EMAIL: JAMES@JLHARDY.COM

CONSULTANTS

STRUCTURAL ENGINEER

REALIZE STRUCTURAL ENGINEERING, INC.
CONTACT: RUSSELL MERRILL SE #184004
2880 WEST 4700 SOUTH, SUITE A
WEST VALLEY CITY, UTAH 84129
OFFICE PHONE (801) 930-9625
EMAIL: INFO@REAL-SEC.COM

ELECTRICAL ENGINEER:

DEAN ENGINEERING
CONTACT: DEAN LEVORSEN PE # 154867
459 WILLOW SPRINGS LANE
DRAPER, UTAH 84020
PHONE (801) 243-0854
E-MAIL: DEANLEVORSEN@MSN.COM

MECHANICAL ENGINEER:

DALE R. WILDE COMPANY
CONTACT: RAY WILDE PE # 1558674
1106 EAST 2700 SOUTH
SALT LAKE CITY, UTAH 84106
PHONE (801) 433-1125 FAX (801) 486-0744
E-MAIL: WILDE@DRWCO.COM

CIVIL ENGINEER:

CIR ENGINEERING, L.L.C.
CONTACT: SCOTT THORSEN, PE # 354291
3032 SOUTH 1030 WEST, SUITE 202
SALT LAKE CITY, UTAH 84119
PHONE (801) 949-6296
E-MAIL: SCOTT@CIREENGINEERING.COM

LANDSCAPE ARCHITECT:

RDL DESIGN COMPANY, INC
CONTACT: ROBERT D LIEN LA #106360
1020 EAST YALE AVENUE
SALT LAKE CITY, UTAH 84105
PHONE (801) 647-3114
E-MAIL: RDLDESIGN@COMCAST.NET

GEOTECHNICAL ENGINEER:


GSH GEOTECHNICAL, INC
CONTACT: WILLIAM G TURNER PE # 171715
CONTACT: WILLIAM BE TURNER PE # 162291
473 WEST 4800 SOUTH
SALT LAKE CITY, UTAH 84123
PHONE (801) 685-9190
E-MAIL: GSH@GEO.COM

2015 EDITION IBC - CODE ANALYSIS

- APPLICABLE CODES:
CURRENT SALT LAKE CITY ORDINANCES
CURRENT STATE OF UTAH ADOPTED AMENDMENTS
2015 INTERNATIONAL BLDG CODE (IBC) INCLUDING APPENDIX J
2015 INTERNATIONAL PLUMBING CODE (IPC)
2015 INTERNATIONAL FUEL & GAS CODE (IFGC)
2015 INTERNATIONAL MECHANICAL CODE (IMC)
2015 INTERNATIONAL ENERGY CONSERVATION CODE (IECC)
2011 NATIONAL ELECTRICAL CODE (NEC)
2015 INTERNATIONAL FIRE CODE (IFC)
ANSI A117.1/2011 ACCESSIBLE CODE
- THE EXISTING BLDG IS AN EXISTING THREE STORY BLDG WITH A SMALL PARTIAL BASEMENT FOR STORAGE AND MECHANICAL. ALL UTILITIES ARE ALREADY STUBBED INTO THE BUILDING. THE BUILDING IS A NON-REINFORCED MASONRY BLDG ORIGINALLY BUILT AROUND 1920 WITH ADDITIONS & REMODELS ASSUMED TO HAVE BEEN DONE IN THE 1930-1960 PERIOD. THE ORIGINAL BUILDING WAS A LUMBER SHOP, THEN A CHURCH AND SOMETIME IN THE 1940-1950 PERIOD USED AS A RETAIL COSTUME RENTAL BUSINESS UNTIL THE BLDG WAS SOLD. IT HAS SINCE BEEN USED AS A RETAIL DESIGNER SPACE AND RECENTLY VACATED. THE REQUIRED PARKING IS EXISTING FOR THE BLDG. THIS BUILDING IS CURRENTLY ASSUMED TO BE A TYPE VB-SM NON-RATED BUILDING PER EXISTING CONSTRUCTION. THE PROPOSED TYPE OF CONSTRUCTION AFTER THE REMODEL WILL BE OCCUPANCY GROUP R-2 AND IS TO BE TYPE VB-SM (NON-RATED).
- THE EXISTING FIRE SPRINKLER SYSTEM (NOW VACATED) WILL BE REMOVED AND A COMPLETE NEW SYSTEM WILL BE INSTALLED TO MEET SECTION 903. THIS WILL BE A DEFERRED SUBMITTAL DIRECTLY FROM THE FIRE SPRINKLER SUB-CONTRACTOR. THE FIRE ALARM SYSTEM WILL ALL BE A DESIGN-BUILD SYSTEM AND IS TO BE A DEFERRED SUBMITTAL ITEM.
- THE SQUARE FOOTAGE OF THIS PROPOSED BUILDING REMODEL IS AS FOLLOWS WITH PROPOSED NUMBER OF UNITS:
BASEMENT • 1384 GROSS SF • PARTIAL BSMT OF 1 LIVE/WORK APT • 724 GROSS SF
MAIN FLOOR • 4,823 GROSS SF • 4 ONE-BEDROOM APTS • 3,425 GROSS SF
UNITS 101 IS A TYPICAL APT AND UNITS 102, 103 AND 104 ARE LIVE WORK UNITS
SECOND FLOOR • 7,230 GROSS SF • 8 ONE-BEDROOM APT • 5,994 GROSS SF
THIRD FLOOR • 7,230 GROSS SF • 5 ONE-BDRM + TWO 2-BDRM APT • 6,147 GROSS SF
TOTAL BLDG • 21,677 GROSS SF • 19 TOTAL APT • 16,270 GROSS SF
- PER TABLE 504.3 FOR OCCUPANCY GROUP R-2, TYPE VB-SM CONSTRUCTION, THE MAXIMUM ALLOWABLE HEIGHT • 60 FT AND MAXIMUM FINISHED HEIGHT ABOVE GRADE AT HIGHEST POINT WILL BE 34'-6" AND PER TABLE 504.4 THE ALLOWABLE # OF STORIES IS 3 AND THE BLDG HAS 3 PER TABLE 504.3 THE ALLOWABLE AREA FOR TYPE VB-SM IS 21,000 SF. PER 506.3.2 IF = 309 AND BLDG PERIMETER ON 30+ FT YARDS = 383 AND W=59.44. PER SECTION 506.3.3 FRONTAGE INCREASE = 1 • (309 / 383 • 0.25) 59.44 / 30 • 59.44 / 30 • 110. TOTAL ALLOWABLE AREA = (21,000 + (21,000 X 1) X 3 • (32,300) SF. ACTUAL = 28,397 GROSS SF.
- THE BUILDING HAS A MINIMUM FIRE SEPARATION DISTANCE OF 75 FT+ ON NORTH (1700 SOUTH), 54'00" ON WEST (1100 EAST), 53'4" ON EAST AND 21'2" ON THE SOUTH (INCLUDES THE ALLEY WIDTH+). FOR TYPE VB-SM OCCUPANCIES PER TABLE 601 ALL BLDG ELEMENTS CAN BE NON-RATED AND PER TABLE 602 ALL EXTERIOR WALLS GREATER THAN 10 FT & LESS THAN 30 FT CAN BE NON-RATED. ALL EXTERIOR WALLS WILL BE NON RATED. MAXIMUM AREA OF UNPROTECTED OPENINGS ALLOWED FOR FIRE SPRINKLER SYSTEM SHALL BE 100 SQ FT.
- UNIT SEPARATION PER SECTIONS 420.2 AND 705 IS TO BE 1/2 HR-RATED WITH SPRINKLER SYSTEM AND HORIZONTAL FLOOR/CEILING SEPARATION PER SECTIONS 420.3 AND 711 IS TO BE 1/2 HR-RATED WITH SPRINKLER SYSTEM UNIT SEPARATION FROM CORRIDORS PER SECTIONS 705.3 AND 10201 AND TABLE 1021 SHALL BE 1/2 HR-RATED WITH SPRINKLER SYSTEM. DOORS IN 1/2 HR RATED CORRIDORS TO BE 1/3 HR RATED 020 MIN DOORS AND FRAMES. 1-HR RATED FLOOR, WALL ASSEMBLIES WILL BE USED. SHAFT AND STAIR ENCLOSURES WILL BE 1-HR RATED AND DOOR AND WINDOW OPENINGS IN SHAFTS SHALL BE 1-HR RATED PER TABLE 716.5.
- PER TABLE 803.1 WITH FIRE SPRINKLERS FOR R-2 OCCUPANCY ALL INTERIOR FINISH MATERIALS SHALL BE CLASS C. REQUIRED # OF EXITS AND WIDTH PER TABLES 1020.1.2, 1026.2.1, 1026.3.1, 10 AND 1015 USED R-2 OCCUPANCY OF 200 SF FOR 57000 LOAD PER THE GROSS APT SF (DID NOT INCLUDE CORRIDORS, ETC)
BASEMENT - PARTIAL LIVE/WORK APT • 724 SF/200 SF • 4 OCC • 1 EXIT REQD AND 1 EXIT PROVIDED THRU SAME APT FLOOR ABOVE
BASEMENT - TENANT STORAGE • 1160 SF/500 SF • 2 OCC • 1 EXIT REQD AND 1 PROVIDED
MAIN FLOOR (4 - 1 BDRM APTS) • 3,425 SF/200 SF • 17 OCC • 2 EXITS REQD AND 4 PROVIDED EACH APT HAS DIRECT EXIT TO MAIN LEVEL
2ND FLOOR (8 - 1 BDRM APTS) • 5,994 SF/200 SF • 30 OCC • 2 EXITS REQD AND TWO EXIT STAIRS PROVIDED
3RD FLOOR (5 - 1 BDRM APTS AND 2 - 2 BDRM APTS) • 6,147 SF/200 SF • 31 OCC • 2 EXITS REQD AND TWO EXIT STAIRS PROVIDED
PER SECTION 1011.2 EXCEPTION #1, THE MINIMUM REQUIRED STAIR WIDTH IS 36" CLEAR AT ALL STAIRS. THE TWO STAIRS ARE IN 1-HR RATED ENCLOSURES WITH WIDTHS OF 44" ON ONE STAIR AND 42" ON THE OTHER. THE STAIR ENTRANCE DOORS ARE SEPARATED BY GREATER THAN 1/3 THE BLDG DIAMETER PER SECTION 1007.11.11. THE LARGEST BLDG DIAGONAL IS 125'-5" AND THE DISTANCE BETWEEN THE CENTER JAMB WIDTH OF BOTH STAIR EXIT DOORS • 42'-2" • GREATER THAN 1/3 THE BLDG DIAMETER 42' 1/2 5/8".
- MAXIMUM ALLOWABLE TRAVEL DISTANCE PER TABLE 1017.2 (SPRINKLERED) • 250 FT AND ALL DISTANCES IN THE PROPOSED BUILDING DESIGN ARE WITHIN THE ALLOWABLE. ALL DEAD ENDS ARE LESS THAN 100 FT PER 1024.4. EXIT SIGNS PER SECTION 1015 AND EXIT ILLUMINATION PER SECTION 10205 WITH BATTERY BACK-UP ARE SHOWN ON THE ELECTRICAL PLANS AT EACH STAIR AND EXIT DOOR LOCATION.
- FOUR (4) FIRE EXTINGUISHERS (FE) ARE REQUIRED WITH ONE (1) WILL BE PROVIDED ON EACH FLOOR, BASEMENT, MAIN (ST) FLOOR, 2ND FLOOR AND 3RD FLOOR IN A CENTRAL LOCATION.
- THE NEW BUILDING WILL MEET ACCESSIBILITY REQUIREMENTS PER CHAPTER 11 AND ICC/ANSI A117.1-2011. BOTH NEW MAIN FLOOR BUILDING ENTRANCES ARE ACCESSIBLE. ONE PUBLIC ACCESSIBLE TOILET IS PROVIDED ON THE MAIN LEVEL FOR THE LIVE/WORK UNITS.
- PER SECTION 1107.6 ALL UNITS WILL BE TYPE B UNITS PER SECTION 1107.6.2.21 • LESS THAN 20' TOTAL UNIT. THERE ARE ONLY 3 LIVE/WORK UNITS PER 1107.6.21 AND ONLY THE NON-RESIDENTIAL SECTION IS ACCESSIBLE UNIT 101 IS NOT A LIVE/WORK UNIT.
- PER SECTION 1207.2 SHALL HAVE A STC OF 50 OR GREATER BETWEEN UNITS AND PUBLIC SPACES.
- SPECIAL INSPECTIONS ARE REQUIRED FOR THIS PROJECT. REFER TO STRUCTURAL NOTES.
- DEFERRED SUBMITTALS:
A. FIRE SPRINKLER DESIGN-BUILD DRAWINGS AND CALCULATIONS
B. FIRE ALARM DESIGN-BUILD DRAWINGS
C. CARPORT STRUCTURE DESIGN-BUILT DRAWINGS, CALCULATIONS AND UTAH SE STAMP
- CONTRACTOR SUBMITTED MECHANICAL SEISMIC BRACING DETAILS

SCHEDULE OF DRAWINGS

SH#	SHEET DESCRIPTION
SP-1	ARCHITECTURAL SPECIFICATIONS
SP-2	ARCHITECTURAL SPECIFICATIONS
SP-3	ARCHITECTURAL SPECIFICATIONS
SP-4	ARCHITECTURAL SPECIFICATIONS
SP-5	ARCHITECTURAL SPECIFICATIONS
SP-6	ARCHITECTURAL SPECIFICATIONS
AS-1	ARCHITECTURAL SITE PLAN & SITE CALCULATIONS
AS-2	ARCHITECTURAL SITE DETAILS
CV	CIVIL COVER SHEET
GN	CIVIL GENERAL NOTES
C-01	SITE DEMOLITION PLAN
C-1	CIVIL SITE PLAN
C-2	GRADING & DRAINAGE PLAN
C-3	SITE UTILITY PLAN
C-4	CIVIL SITE DETAILS
C-5	EROSION CONTROL PLAN (SWPPP)
C-6	EROSION CONTROL DETAIL SHEET
L-11	LANDSCAPE PLAN, SITE CALCULATIONS & PLANT LIST
L-21	IRRIGATION PLAN
L-31	LANDSCAPE & IRRIGATION DETAILS
D-01	EXISTING BLDG BASEMENT & MAIN FLOOR DEMOLITION PLANS
D-02	EXISTING BLDG 2ND FLOOR DEMOLITION PLAN
D-03	EXISTING BLDG 3RD FLOOR DEMOLITION PLAN
A-F-0	FIRESTOP PENETRATION DETAILS
A-01	BASEMENT PLAN & BASEMENT DIMENSION PLAN
A-02	BASEMENT FINISH PLAN & BASEMENT REFLECTED CEILING PLAN
A-11	MAIN FLOOR PLAN
A-12	MAIN FLOOR DIMENSION PLAN
A-13	MAIN FLOOR FINISH PLAN
A-14	MAIN FLOOR REFLECTED CEILING PLAN
A-21	SECOND FLOOR PLAN
A-22	SECOND FLOOR DIMENSION PLAN
A-23	SECOND FLOOR FINISH PLAN
A-24	SECOND FLOOR REFLECTED CEILING PLAN
A-31	THIRD FLOOR PLAN
A-32	THIRD FLOOR DIMENSION PLAN
A-33	THIRD FLOOR FINISH PLAN
A-34	THIRD FLOOR REFLECTED CEILING PLAN
A-41	ROOF PLAN
A-51	FINISH SCHEDULE & HCAP DETAILS
A-61	DOOR SCHEDULE & DOOR TYPES
A-62	WINDOW SCHEDULE & WINDOW TYPES
A-71	NORTH EXTERIOR ELEVATION
A-72	WEST EXTERIOR ELEVATION
A-73	EAST EXTERIOR ELEVATION
A-74	SOUTH EXTERIOR ELEVATION
S-01	STRUCTURAL NOTES
S-02	STRUCTURAL NOTES
S-02	STRUCTURAL CONCRETE DETAILS
S-03	STRUCTURAL FRAMING DETAILS
S-10	MAIN FLOOR AND BASEMENT FTG & FDN PLANS
S-11	SECOND FLOOR FRAMING PLAN & SHEAR WALL SCHEDULE
S-12	THIRD FLOOR FRAMING PLAN
S-13	ROOF FRAMING PLAN
S-30	BUILDING SECTIONS
S-30	ROOF AND 3RD FLOOR RAISING DETAILS
S-51	ROOF AND 3RD FLOOR RAISING DETAILS
S-52	SHOTCRETE WALL DETAILS
S-53	BRACING & STRUCTURAL DETAILS
S-54	STAIR & STRUCTURAL DETAILS
S-55	BLDG SECTIONS & DETAILS
S-56	BLDG SECTIONS & DETAILS
S-57	BLDG SECTIONS & DETAILS
MP-1	MECHANICAL & PLUMBING SPECIFICATIONS
MP-2	MECHANICAL & PLUMBING SPECIFICATIONS
MP-3	MECHANICAL & PLUMBING SPECIFICATIONS
MP-4	MECHANICAL & PLUMBING SPECIFICATIONS
M-10	BASEMENT MECHANICAL PLAN
M-11	MAIN FLOOR MECHANICAL PLAN
M-12	SECOND FLOOR MECHANICAL PLAN
M-13	THIRD FLOOR MECHANICAL PLAN
M-14	ROOF MECHANICAL PLAN
M-21	MECHANICAL NOTES & DETAILS
M-31	SPLIT SYSTEM EQUIPMENT SCHEDULE
M-32	MECHANICAL EQUIPMENT SCHEDULES
P-10	BASEMENT WASTE & PIPING FLOOR PLAN
P-11	MAIN FLOOR WASTE & PIPING FLOOR PLAN
P-12	SECOND FLOOR WASTE & PIPING FLOOR PLAN
P-13	THIRD FLOOR WASTE & PIPING FLOOR PLAN
P-14	ROOF WASTE & VENT PIPING PLAN
P-21	BASEMENT WATER & GAS PIPING PLAN
P-21	MAIN FLOOR WATER & GAS PIPING PLAN
P-22	SECOND FLOOR WATER & GAS PIPING PLAN
P-23	THIRD FLOOR WATER & GAS PIPING PLAN
P-31	PLUMBING SCHEDULES, CALCULATIONS AND NOTES
P-32	PLUMBING SCHEDULES
P-41	PLUMBING FIXTURES SCHEDULES
P-51	PLUMBING DETAILS
P-52	PLUMBING DETAILS
E-01	ELECTRICAL NOTES, SPECIFICATIONS & SYMBOL SCHEDULE
E-02	BASEMENT LIGHTING & POWER PLANS
E-03	FIRST FLOOR POWER PLAN
E-04	FIRST FLOOR LIGHTING PLAN
E-05	SECOND FLOOR POWER PLAN
E-06	SECOND FLOOR LIGHTING PLAN
E-07	THIRD FLOOR POWER PLAN
E-08	THIRD FLOOR LIGHTING PLAN
E-09	ROOF POWER PLAN
E-10	PANEL SCHEDULES
E-11	PANEL SCHEDULES
E-12	FIXTURE SCHEDULE & ONE-LINE DIAGRAM
E-13	SITE ELECTRICAL PLAN & CHARGING STATION

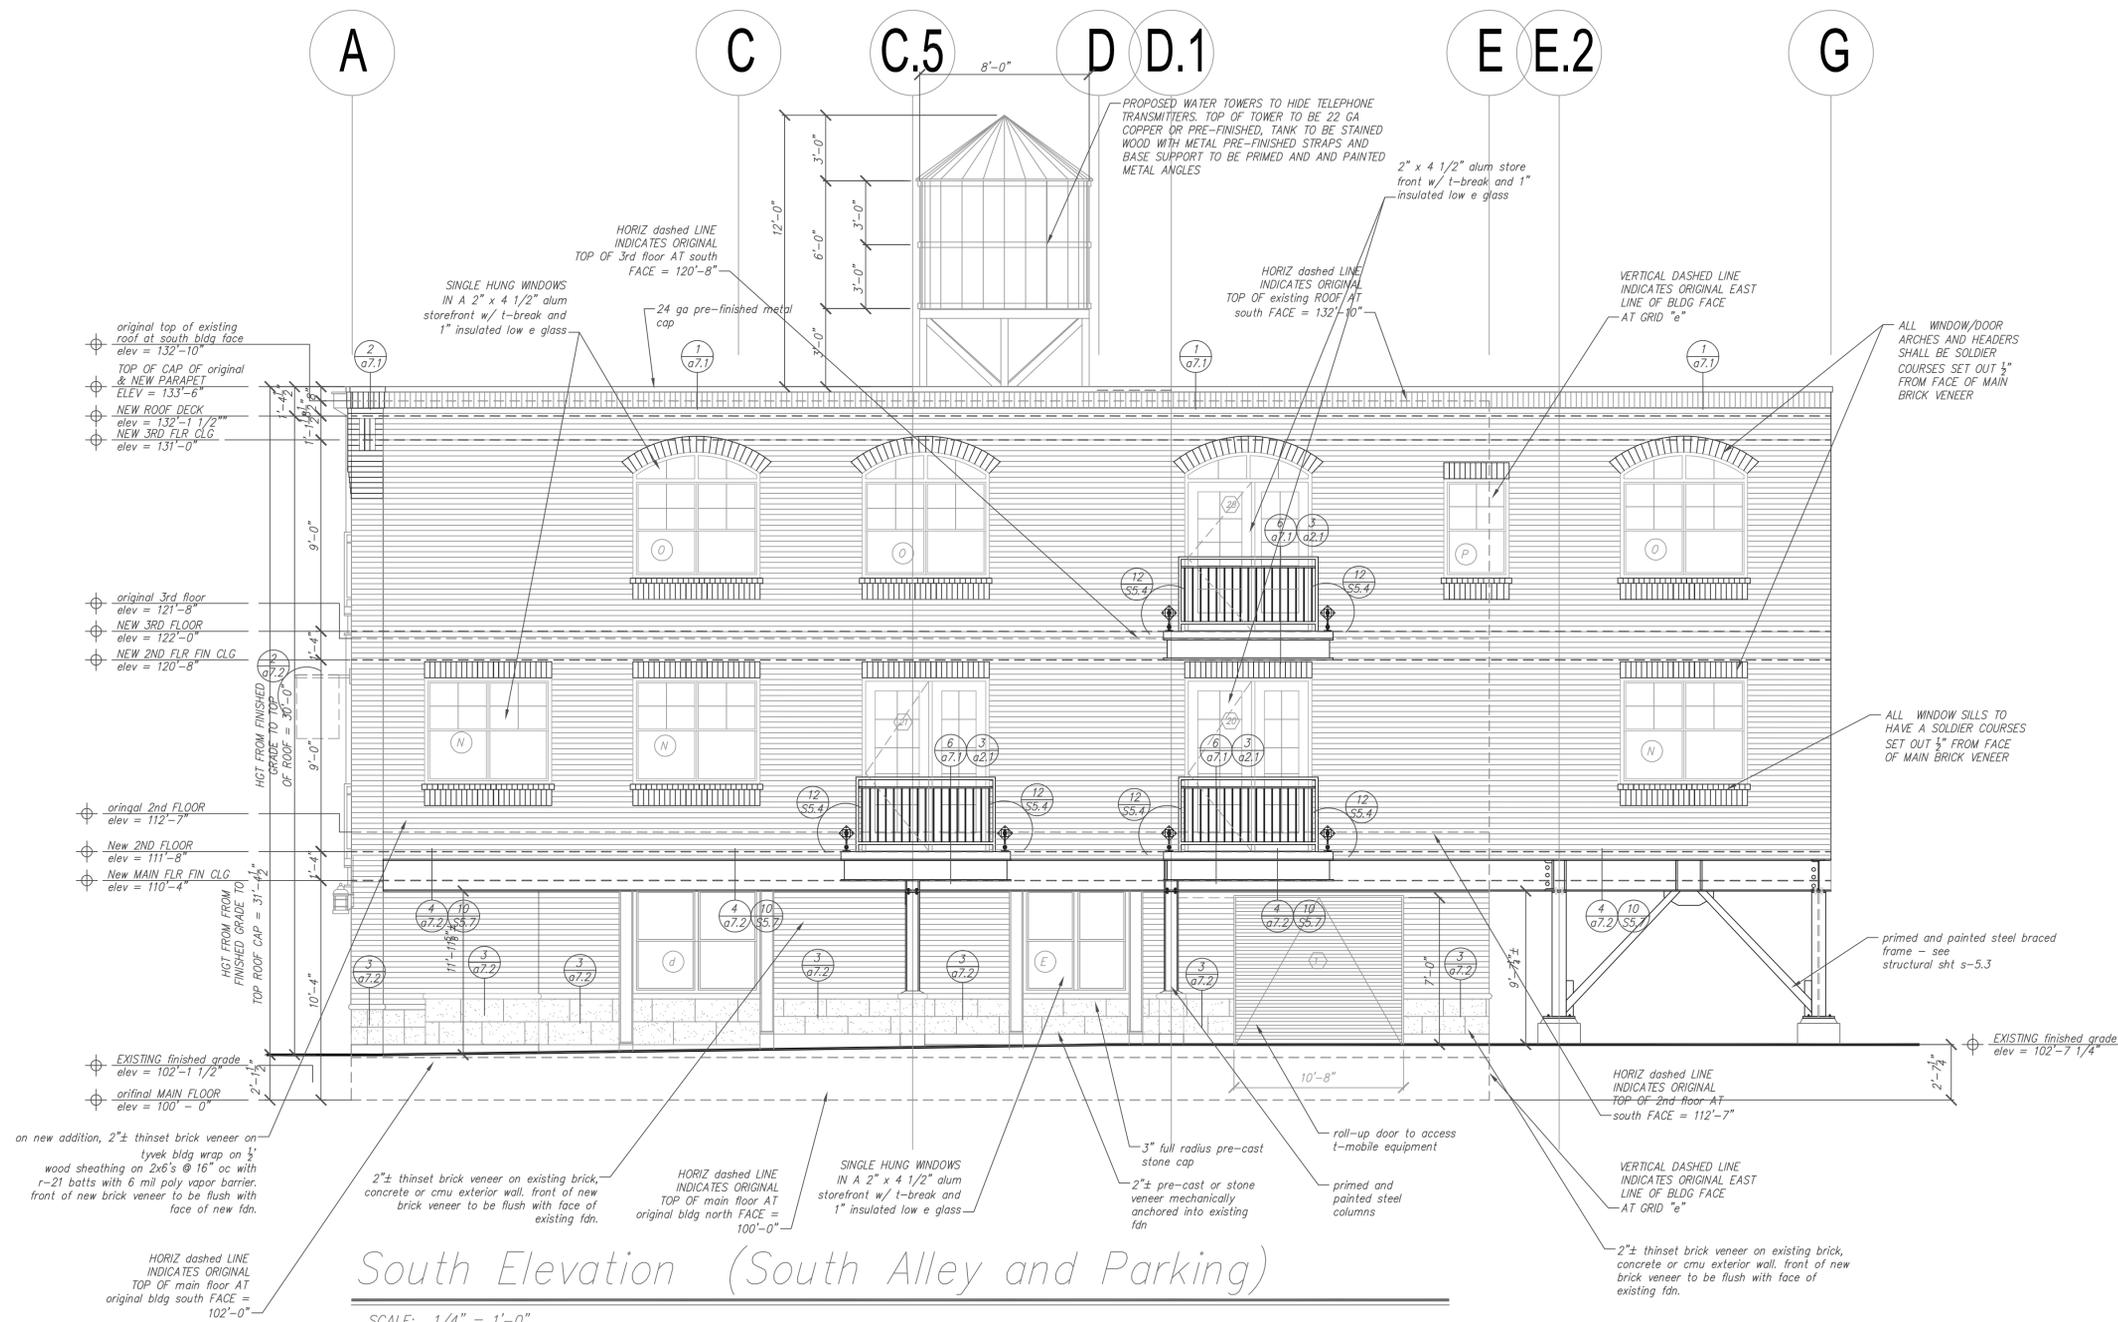

James B. Glascock, Architect P.C.
 Architecture • Planning
 4897 Rebecca Circle
 Salt Lake City, Utah 84117
 801 - 272 - 5133 e-mail: jglascock@mtcon.net



ALL RIGHTS RESERVED. JAMES B. GLASCOCK, ARCHITECT. COPYRIGHT © 2017
 This drawing is identified as part of an unpublished collection of visual art. Under the 1976 copyright act, it is an exclusive original work of authorship. None of the pictorial, graphic or technical charts or drawings depicted on this sheet may be reproduced, stored in a retrieval system, or transmitted in any form or by any means electronic, mechanical or otherwise without the express prior written permission of the architect.


Project 15-027

Revisions

12/01/16	A7.4
----------	------

Date 12/01/16

remodel for:
 salt lake costume building
 1701 south 1100 east
 salt lake city, utah

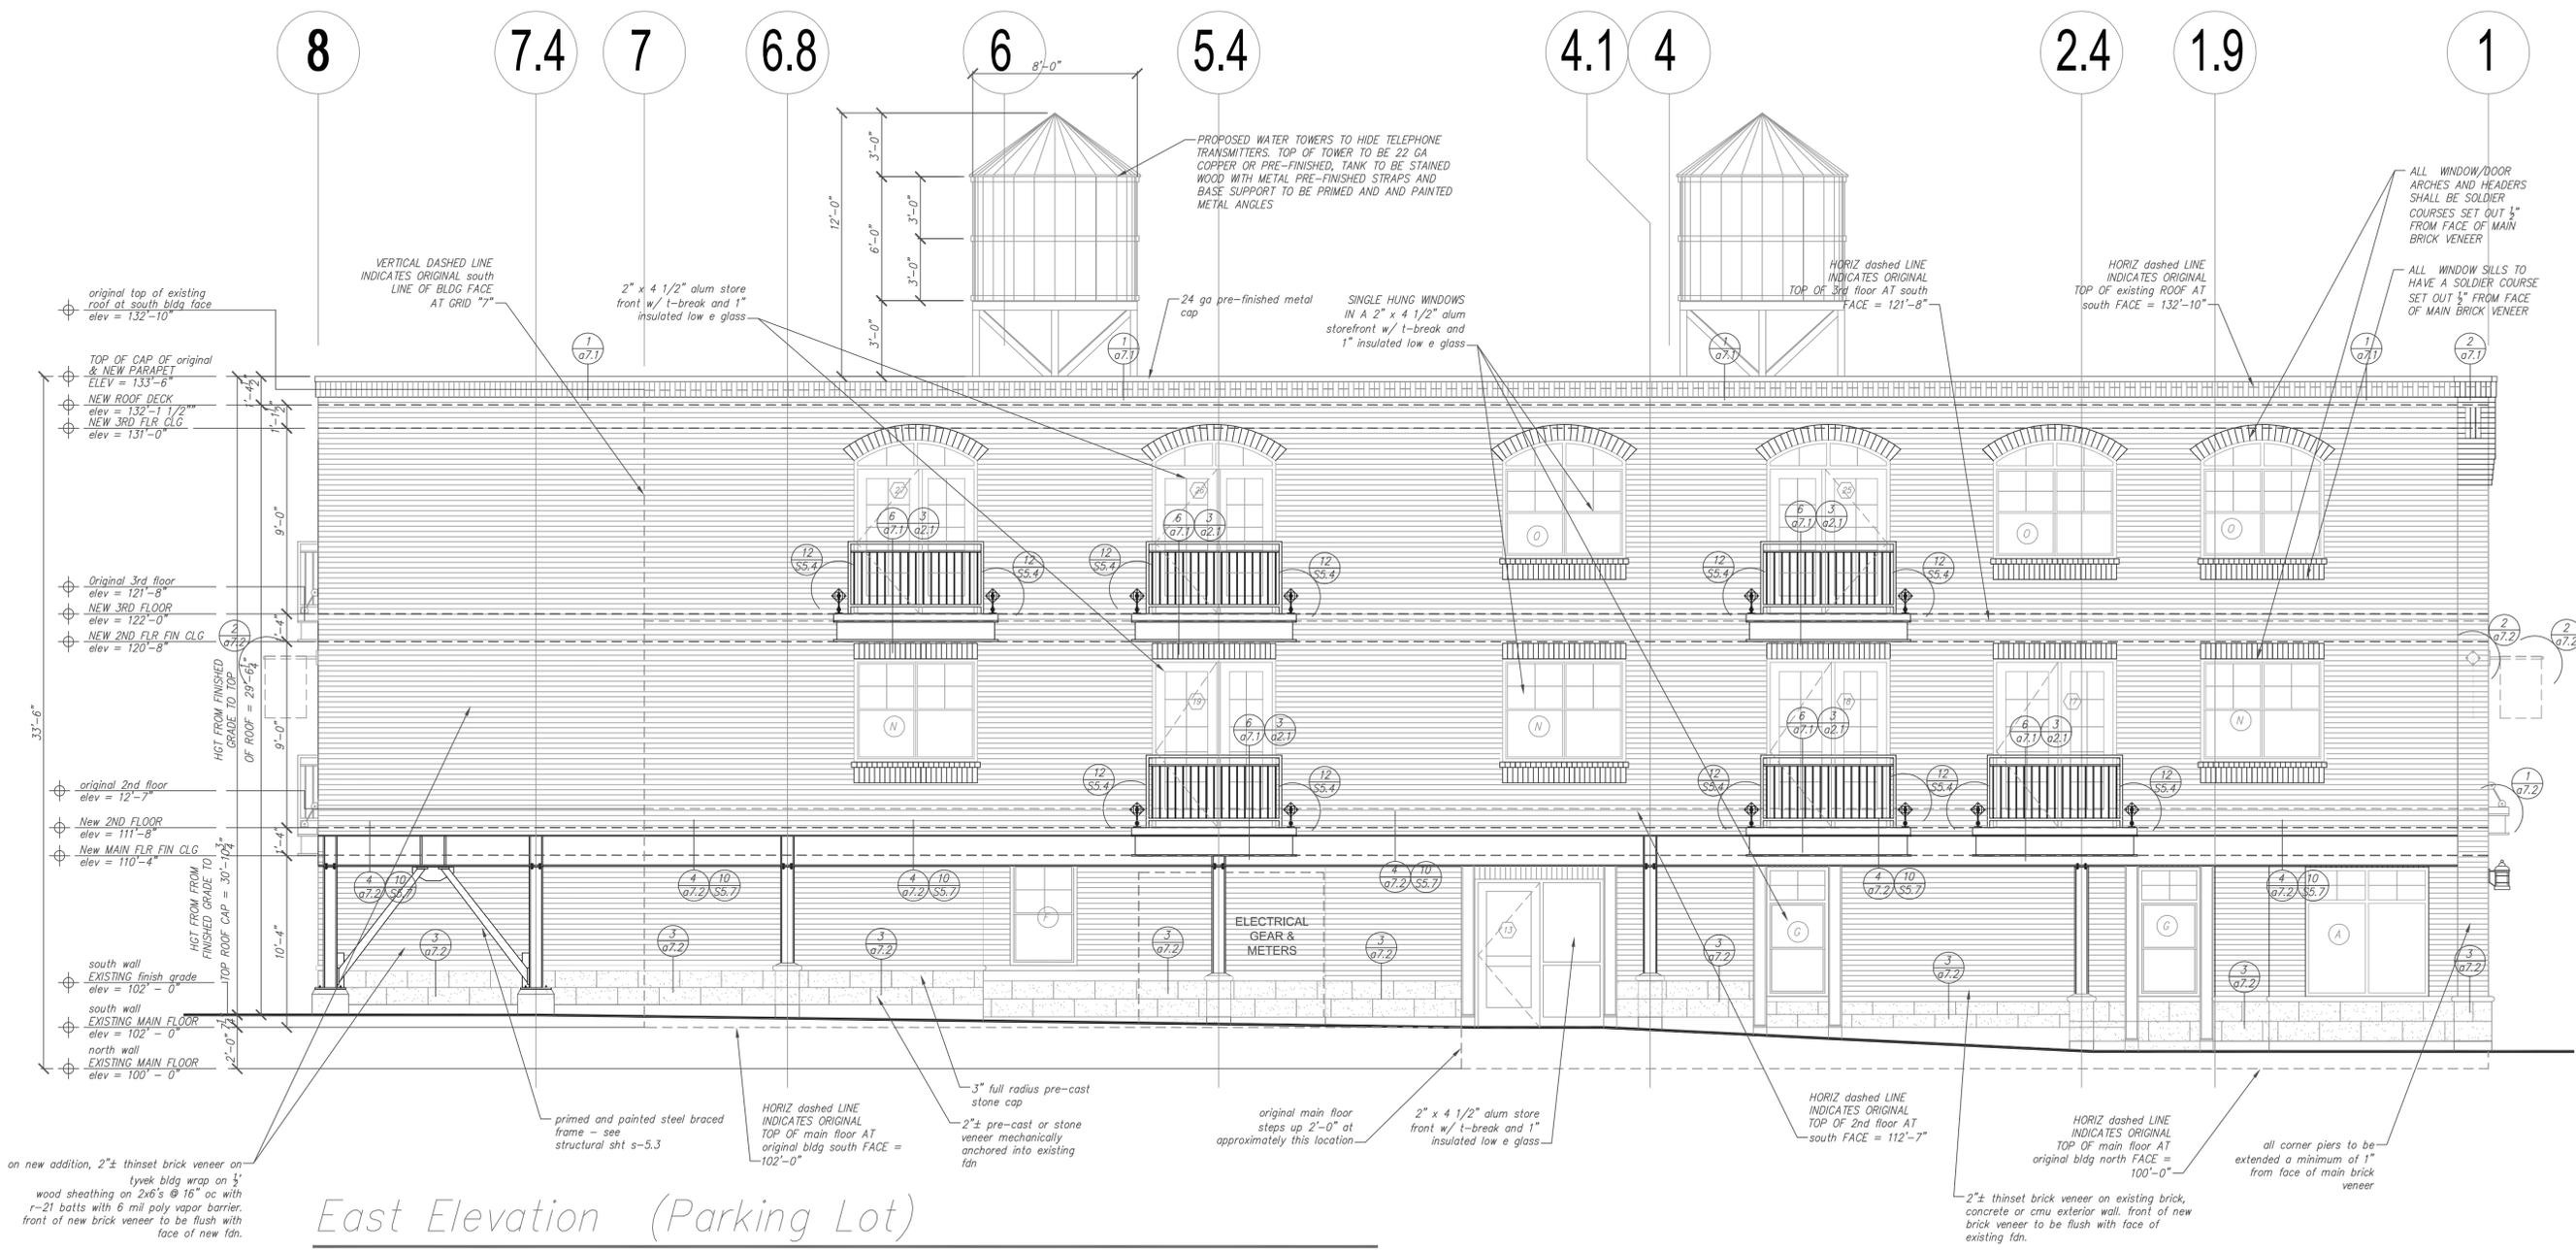

East Elevation (Parking Lot)

SCALE: 1/4" = 1'-0"

04-05-17 - SLC dept Plan Reviews and owner value engineering corrections

James B. Glascock, Architect P.C.
 Architecture • Planning
 4897 Rebecca Circle
 Salt Lake City, Utah 84117
 801 - 272 - 5133 e-mail: jglascock@mtcon.net




ALL RIGHTS RESERVED JAMES B. GLASCOCK ARCHITECT COPYRIGHT
 This drawing is classified as part of an unpublished collection of visual art. Under the 1976 copyright act, it is an exclusive original work of authorship. None of the mechanical, graphic or technical charts or drawings depicted on this sheet may be reproduced or transmitted in any form or by any means electronic, mechanical or otherwise without the express prior written permission of the architect.

Project 15-027
 remodel for:
 salt lake costume building
 1701 south 1100 east
 salt lake city, utah


Date	Revisions
12/01/16	A7.3

Date 12/01/16

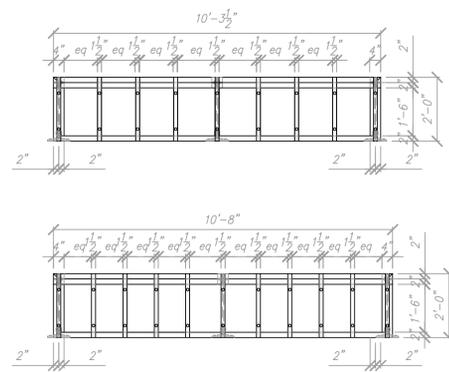


PLANS
1/8" = 1'-0"


(5) canopies

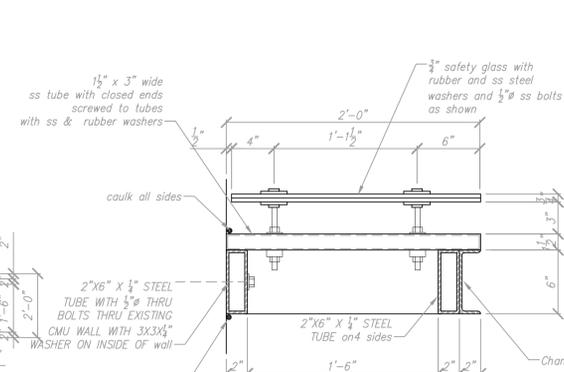


SECTION
1/8" = 1'-0"

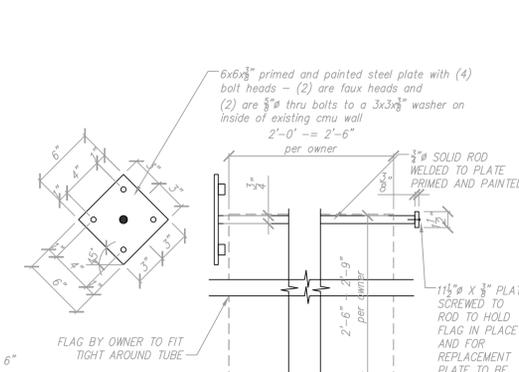

(2) flag detail - to be by sign permit
1/8" = 1'-0" must be submitted for zoning approval

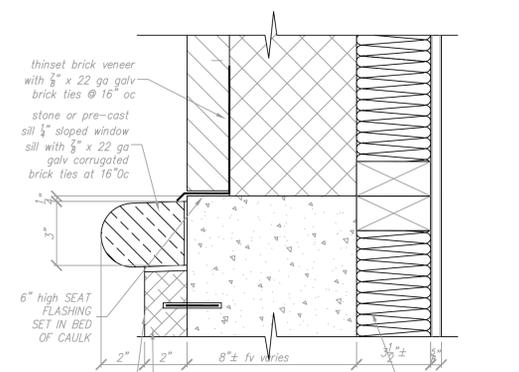


(3) stone window sill detail
3" = 1'-0"

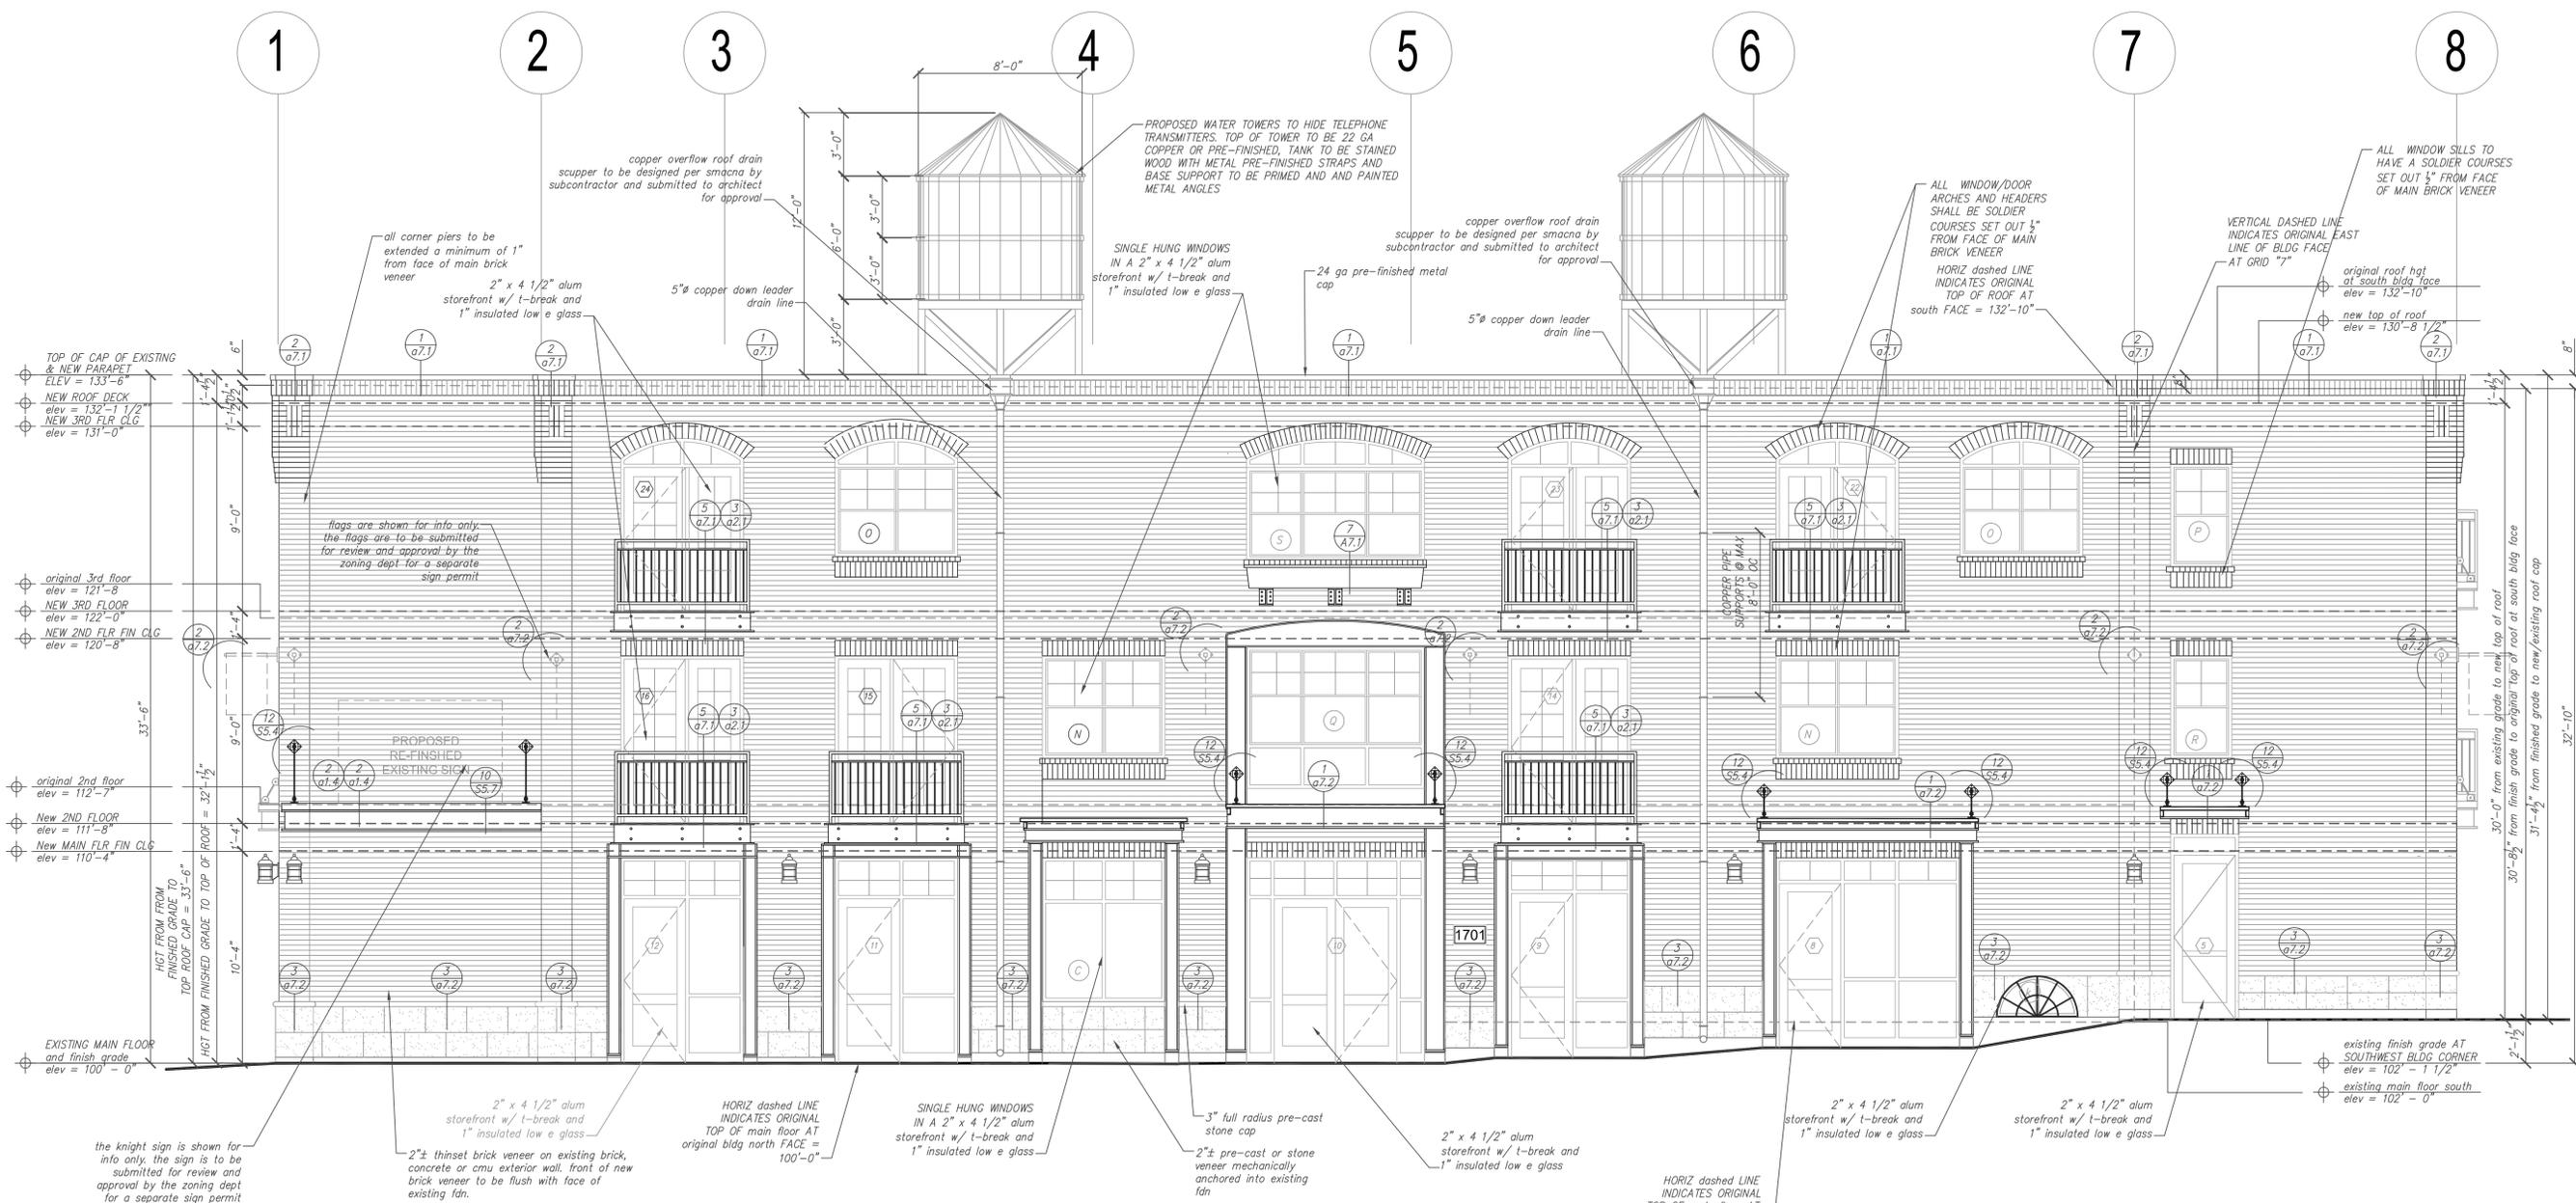

West Elevation (1100 East STREET)

SCALE: 1/4" = 1'-0"


James B. Glascock, Architect P.C.
 Architecture • Planning
 4897 Rebecca Circle
 Salt Lake City, Utah 84117
 801 - 272 - 5133 e-mail: glascock@mtcon.net

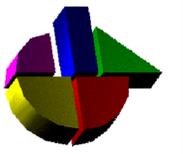


ALL RIGHTS RESERVED JAMES B. GLASCOCK ARCHITECT COPYRIGHT
 This drawing is classified as part of an unpublished collection of work art. Under the 1976 copyright act, it is an exclusive original work of authorship. None of the pictorial, graphic or technical charts or drawings depicted on this sheet may be reproduced, stored in a retrieval system, or transmitted in any form or by any means electronic, mechanical or otherwise without the express prior written permission of the architect.

Project 15-027
 remodel for:
 salt lake costume building
 1701 south 1100 east
 salt lake city, utah


Date	12/01/16
Revisions	A7.2

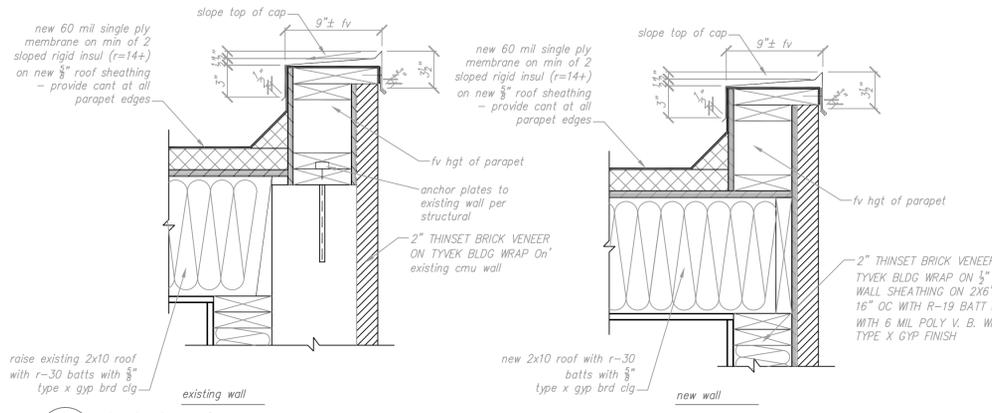


1 typical roof cap
a7.1 1/2" = 1'-0" refer to structural details - field verify all conditions with architect

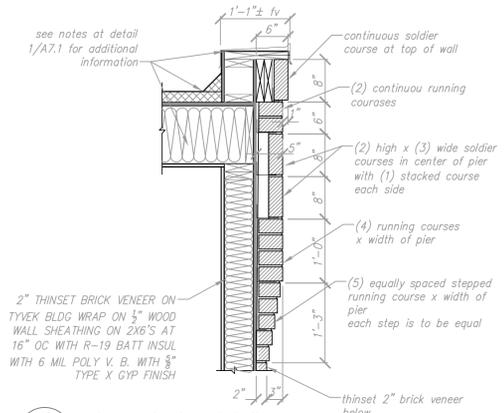


2 stepped pier detail
a7.1 3/4" = 1'-0"

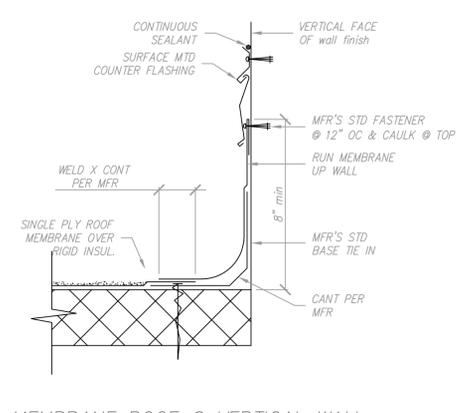

3 MEMBRANE ROOF @ VERTICAL WALL
a7.1 3" = 1'-0"

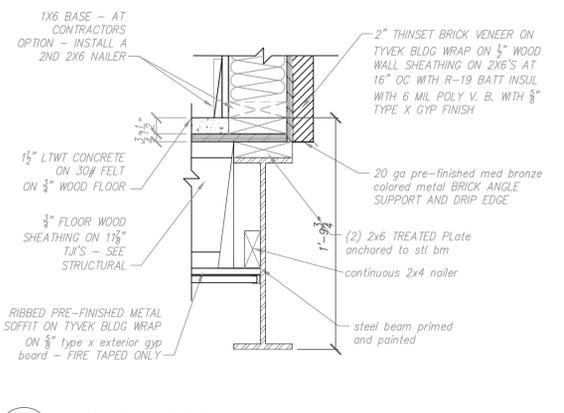


4 wall edge detail
a7.1 1 1/2" = 1'-0" see structural detail 10/s5.7

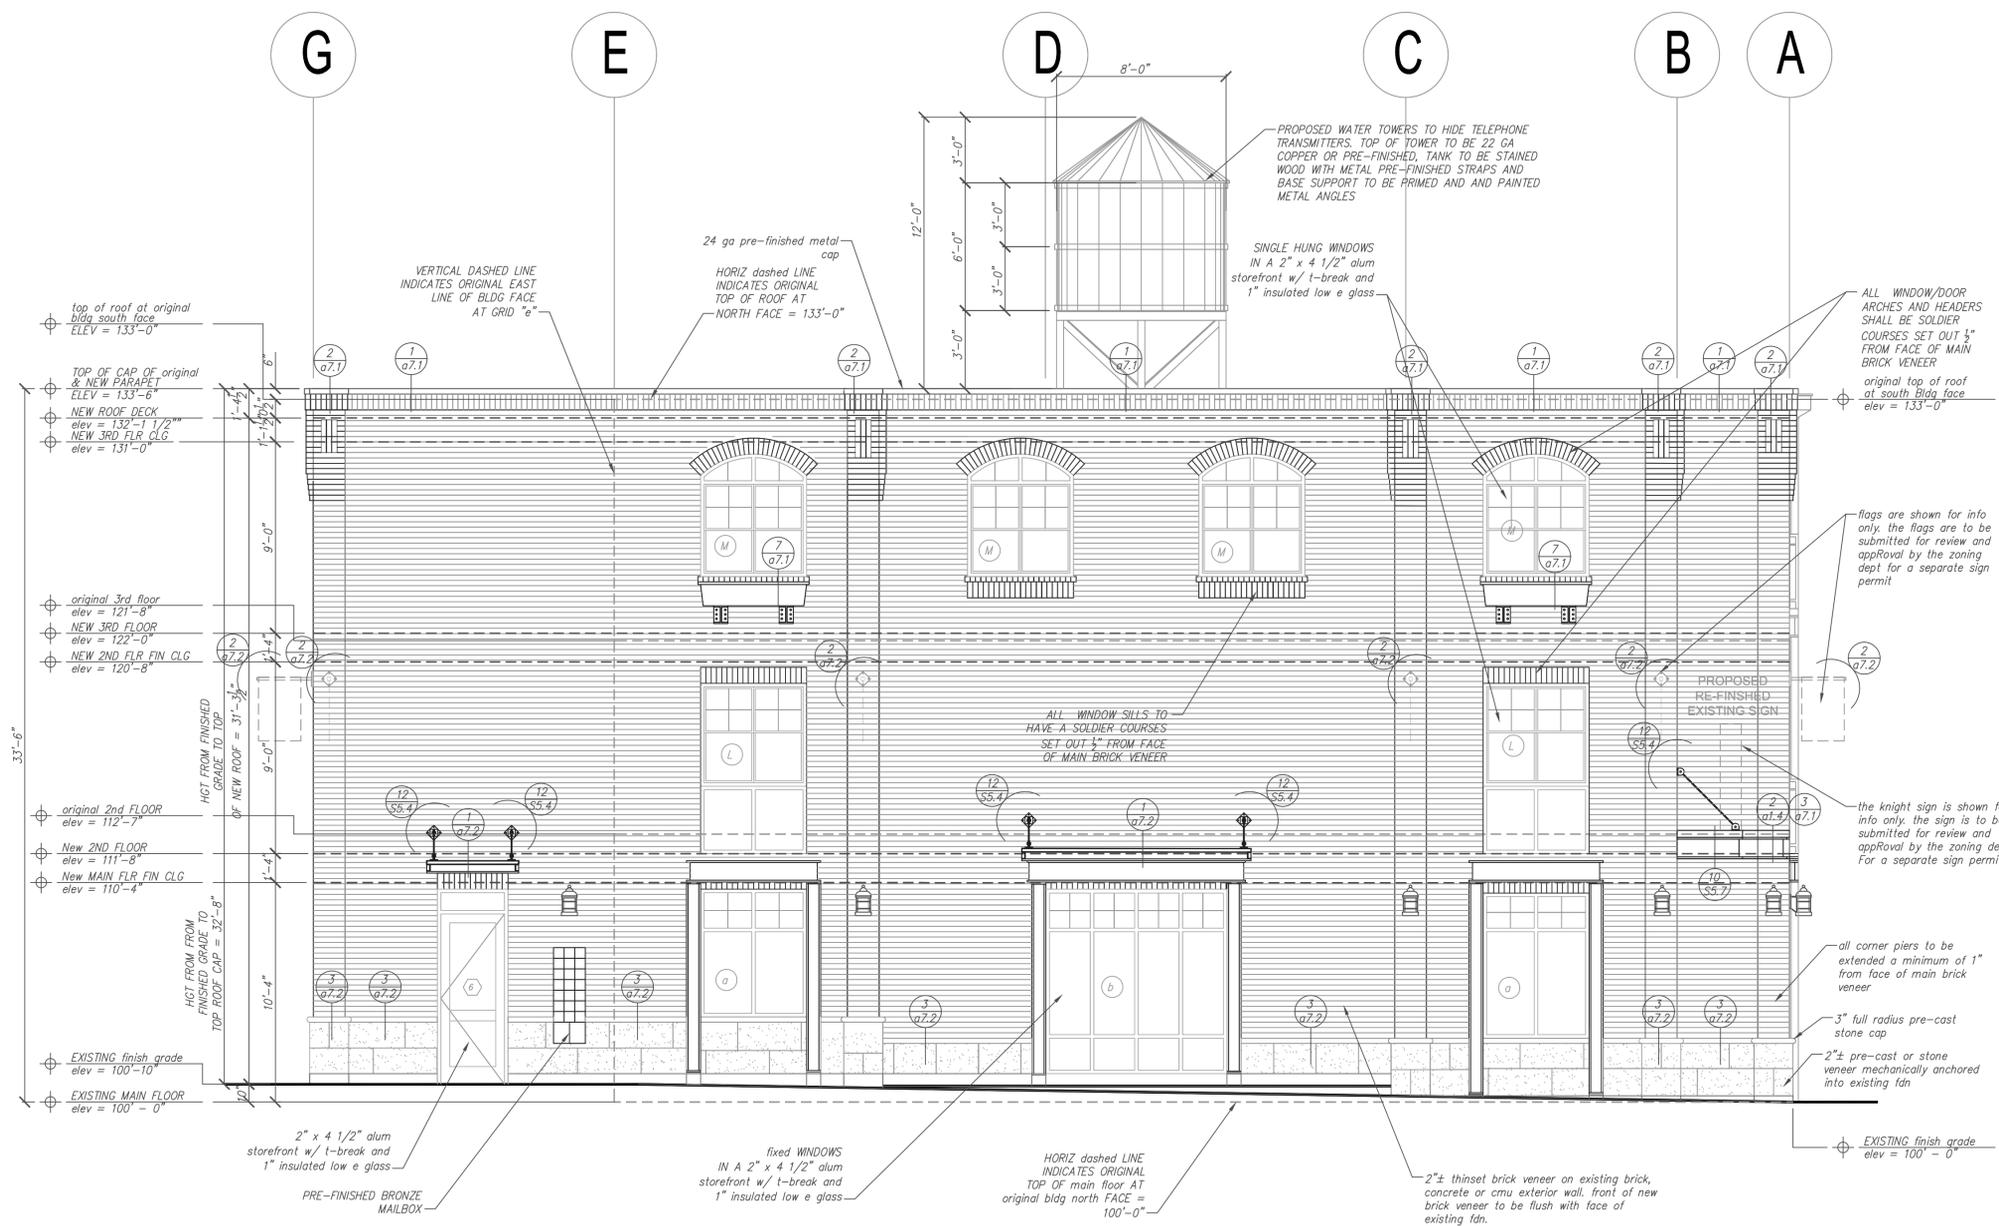


North Elevation (1700 SOUTH STREET)

SCALE: 1/4" = 1'-0"


04-05-17 - SLC dept Plan Reviews and owner value engineering corrections

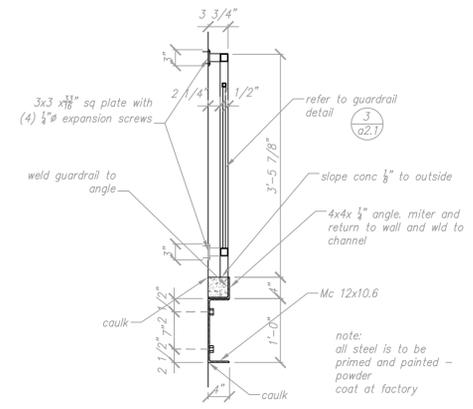

5 4" deep deck detail
a7.1 3/4" = 1'-0" this detail on 1100 east only

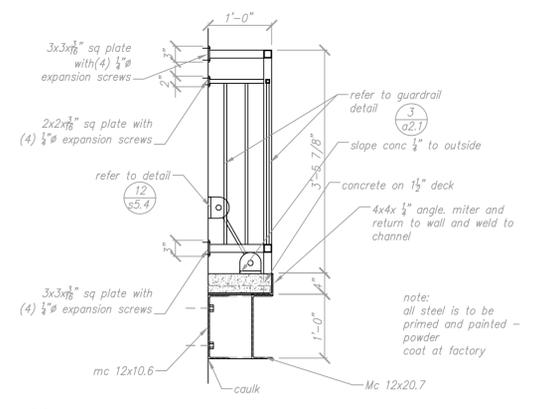


6 12" deep standard deck detail
a7.1 1 1/2" = 1'-0" this detail on east and south only

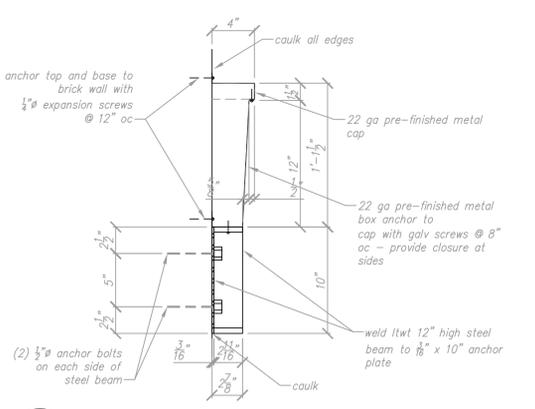

7 4" deep decorative planter
a7.1 1 1/2" = 1'-0"


James B. Glascock, Architect P.C.
Architecture • Planning
4897 Rebecca Circle
Salt Lake City, Utah 84117
801 - 272 - 5133 e-mail: jglascock@mtcon.net

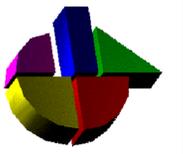

ALL RIGHTS RESERVED. JAMES B. GLASCOCK, ARCHITECT. COPYRIGHT 1976. This drawing is classified as part of an unpublished collection of visual art. Under the 1976 copyright act, it is an exclusive original work of authorship. None of the mechanical, graphic or technical charts or drawings depicted on this sheet may be reproduced, stored in a retrieval system, or transmitted in any form or by any means electronic, mechanical or otherwise without the express prior written permission of the architect.

Project 15-027
remodel for:
salt lake costume building
1701 south 1100 east
salt lake city, utah

Date	12/01/16																					
Revisions	<table border="1"> <tr> <td>1</td> <td>04/05/17</td> <td></td> </tr> <tr> <td>2</td> <td></td> <td></td> </tr> <tr> <td>3</td> <td></td> <td></td> </tr> <tr> <td>4</td> <td></td> <td></td> </tr> <tr> <td>5</td> <td></td> <td></td> </tr> <tr> <td>6</td> <td></td> <td></td> </tr> <tr> <td>7</td> <td></td> <td></td> </tr> </table>	1	04/05/17		2			3			4			5			6			7		
1	04/05/17																					
2																						
3																						
4																						
5																						
6																						
7																						
	A7.1																					

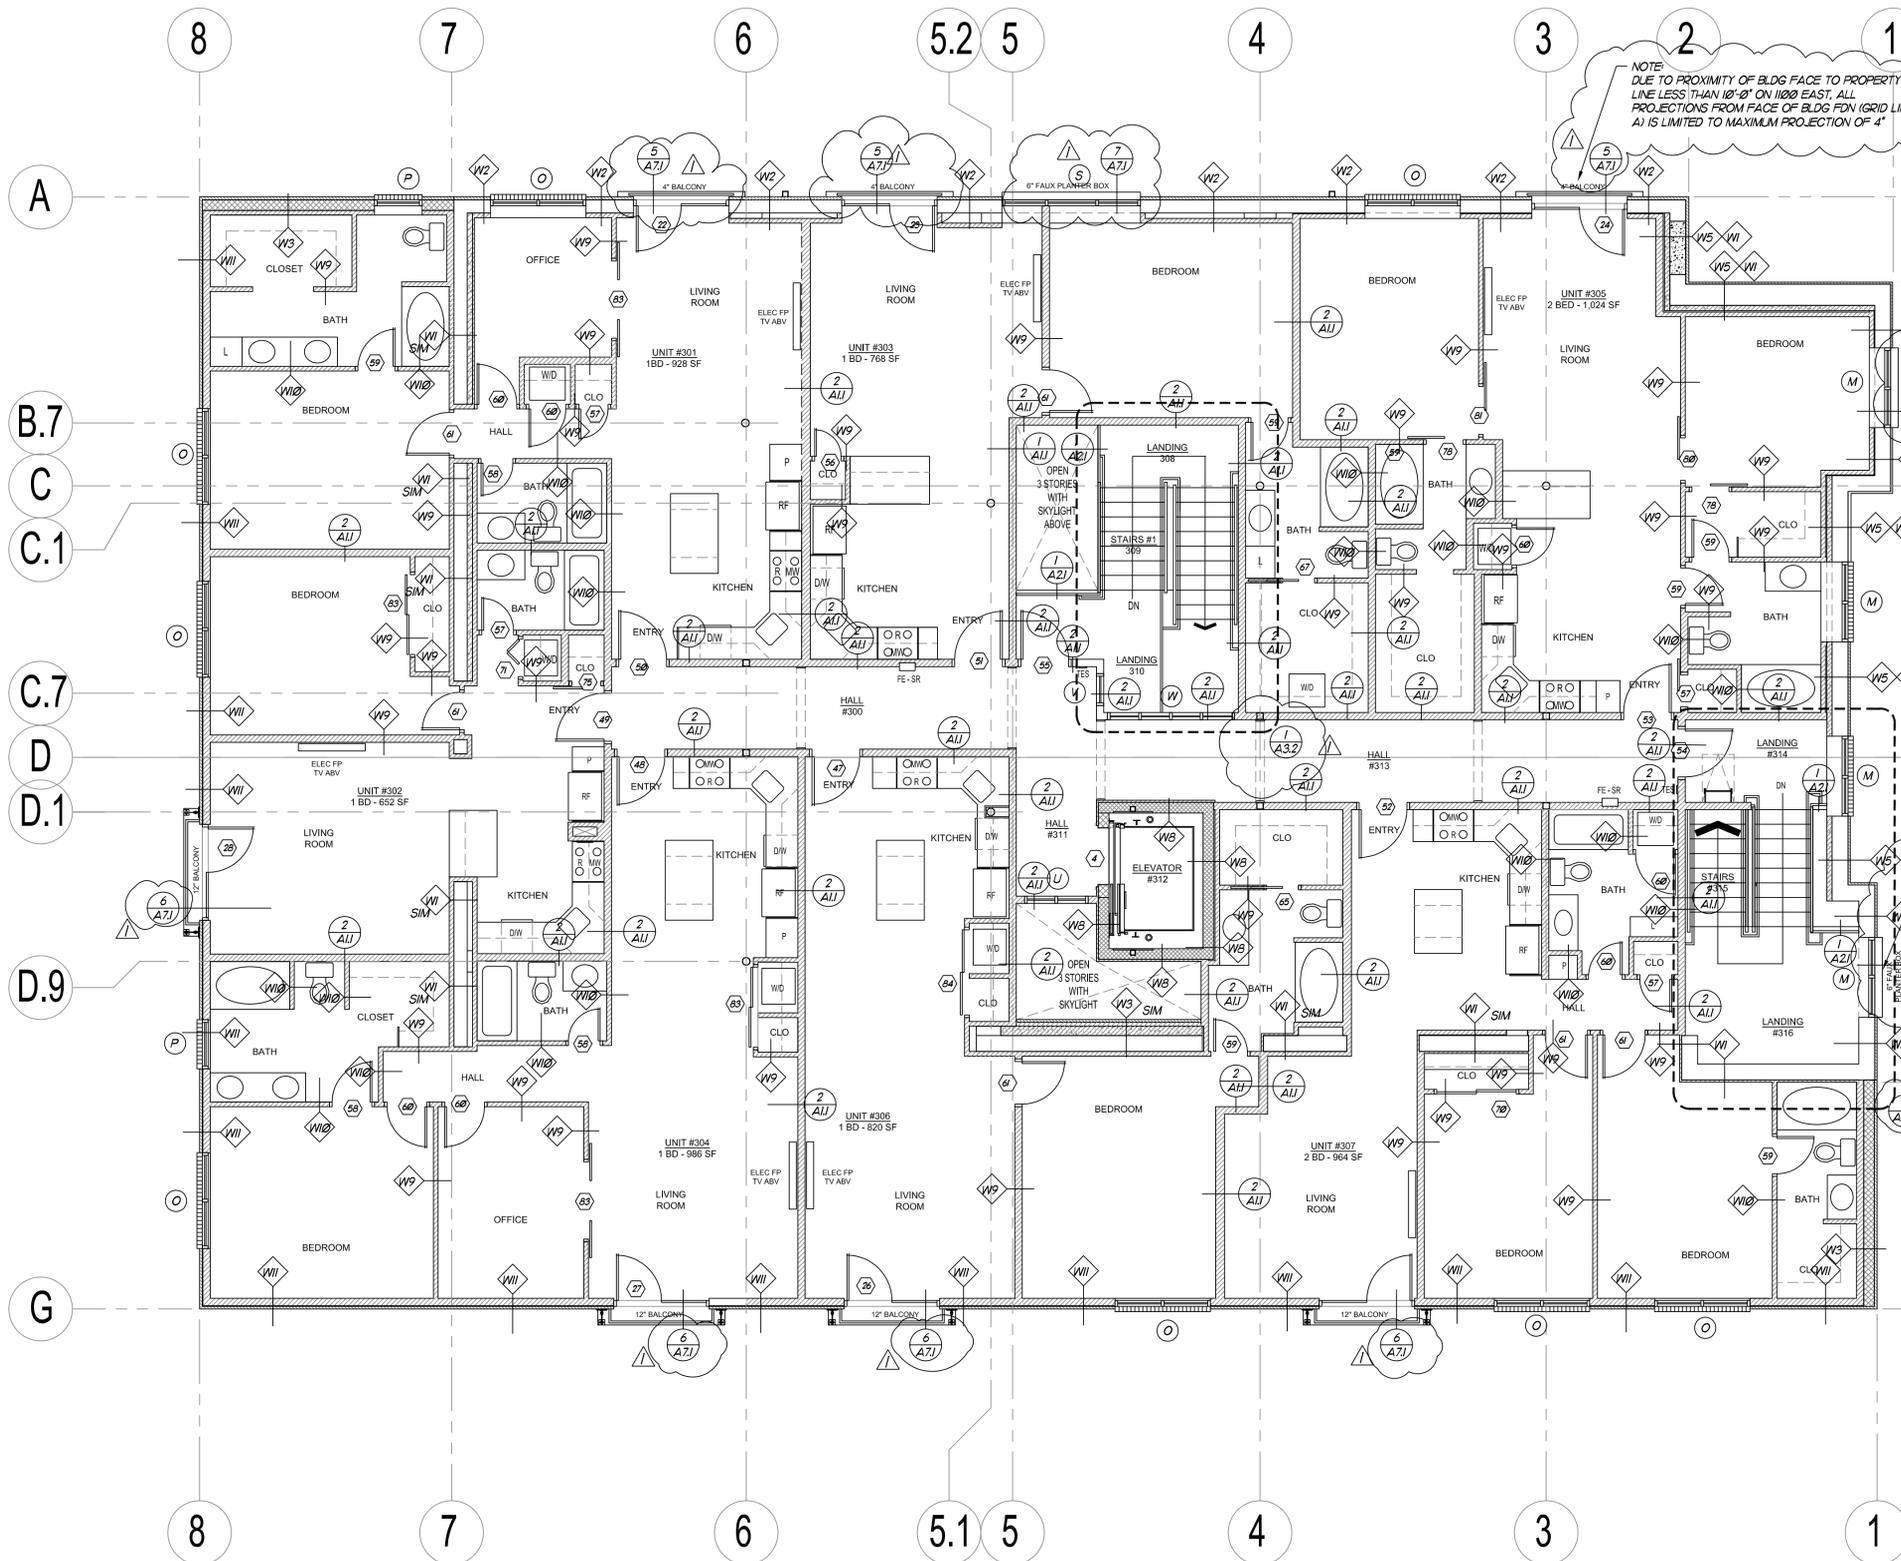


3RD FLOOR PLAN


SCALE: 3/16" = 1'-0"



- NOTES:
 TES = TACTILE EXIT SIGN
 FE SR = SEMI-RECESSED FIRE EXTINGUISHER CABINET
 FACP = FIRE ALARM CONTROL PANEL
 MTR OR MTRS = METERS OR METERS
 FDC = FIRE DEPARTMENT CONNECTION
 ELEC FP = ELECTRIC FIRE PLACE
 WIC = WALK IN CLOSET
 CLO = CLOSET
 P = PANTRY
 L = LINEN CABINET
 DW = DISHWASHER
 WD = STACKED WASHER & DRYER
 REF OR RF = REFRIGERATOR
 MW = MICROWAVE
 R = RANGE
 DN = DOWN
 RD = ROOF DRAIN

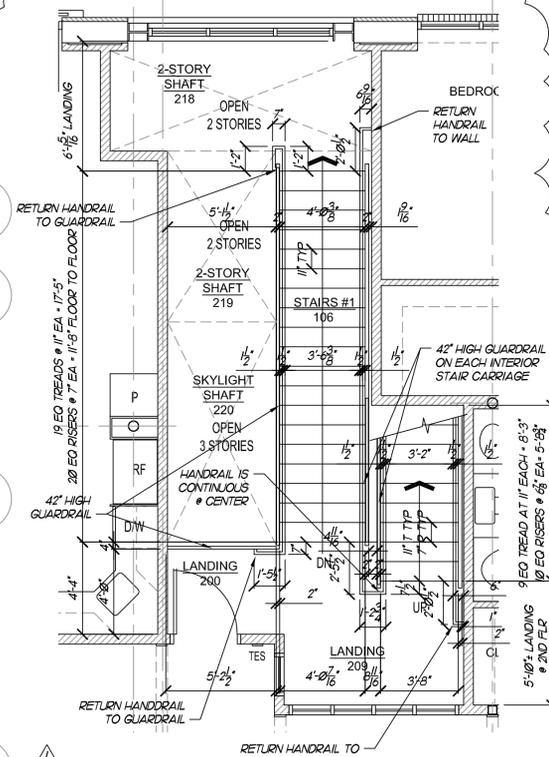

1 STAIR #1 - 2ND FLOOR PLAN
 SCALE: 1/4" = 1'-0"

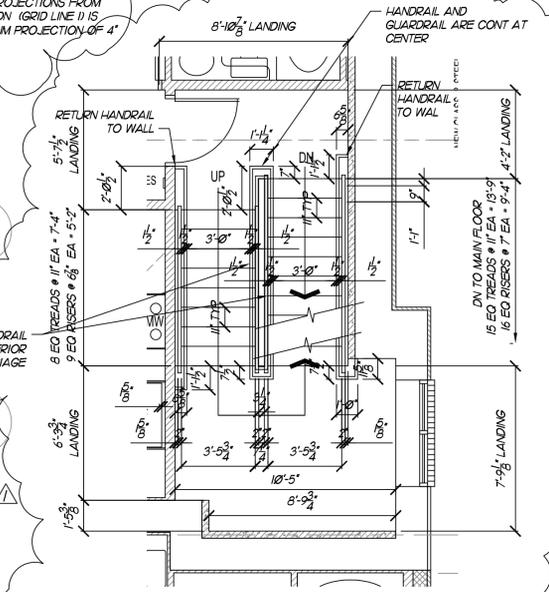

2 STAIR #2 - 2ND FLOOR PLAN
 SCALE: 1/4" = 1'-0"

James B. Glascock, Architect P.C.
 Architecture • Planning
 4897 Rebecca Circle
 Salt Lake City, Utah 84117
 801 - 272 - 5133 e-mail: jglascock@mtcon.net




ALL RIGHTS RESERVED. JAMES B. GLASCOCK, ARCHITECT. COPYRIGHT © 2017
 This drawing is classified as part of an unpublished collection of work. Under the 1976 copyright act, it is an exclusive original work of authorship. None of the precatory, graphic or technical sheets or drawings depicted on this sheet may be reproduced, stored in a retrieval system, or transmitted in any form or by any means electronic, mechanical, photocopying, recording, or by any information storage and retrieval system without the express prior written permission of the architect.

Project 15-027
 REMODEL FOR:
 SALT LAKE COSTUME BUILDING
 1701 SOUTH 1100 EAST
 SALT LAKE CITY, UTAH

Date 12/01/16
 Revisions
 A-3.1

04-05-17 - SLC DEPT PLAN REVIEWS AND OWNER VALLE ENGINEERING CORRECTIONS

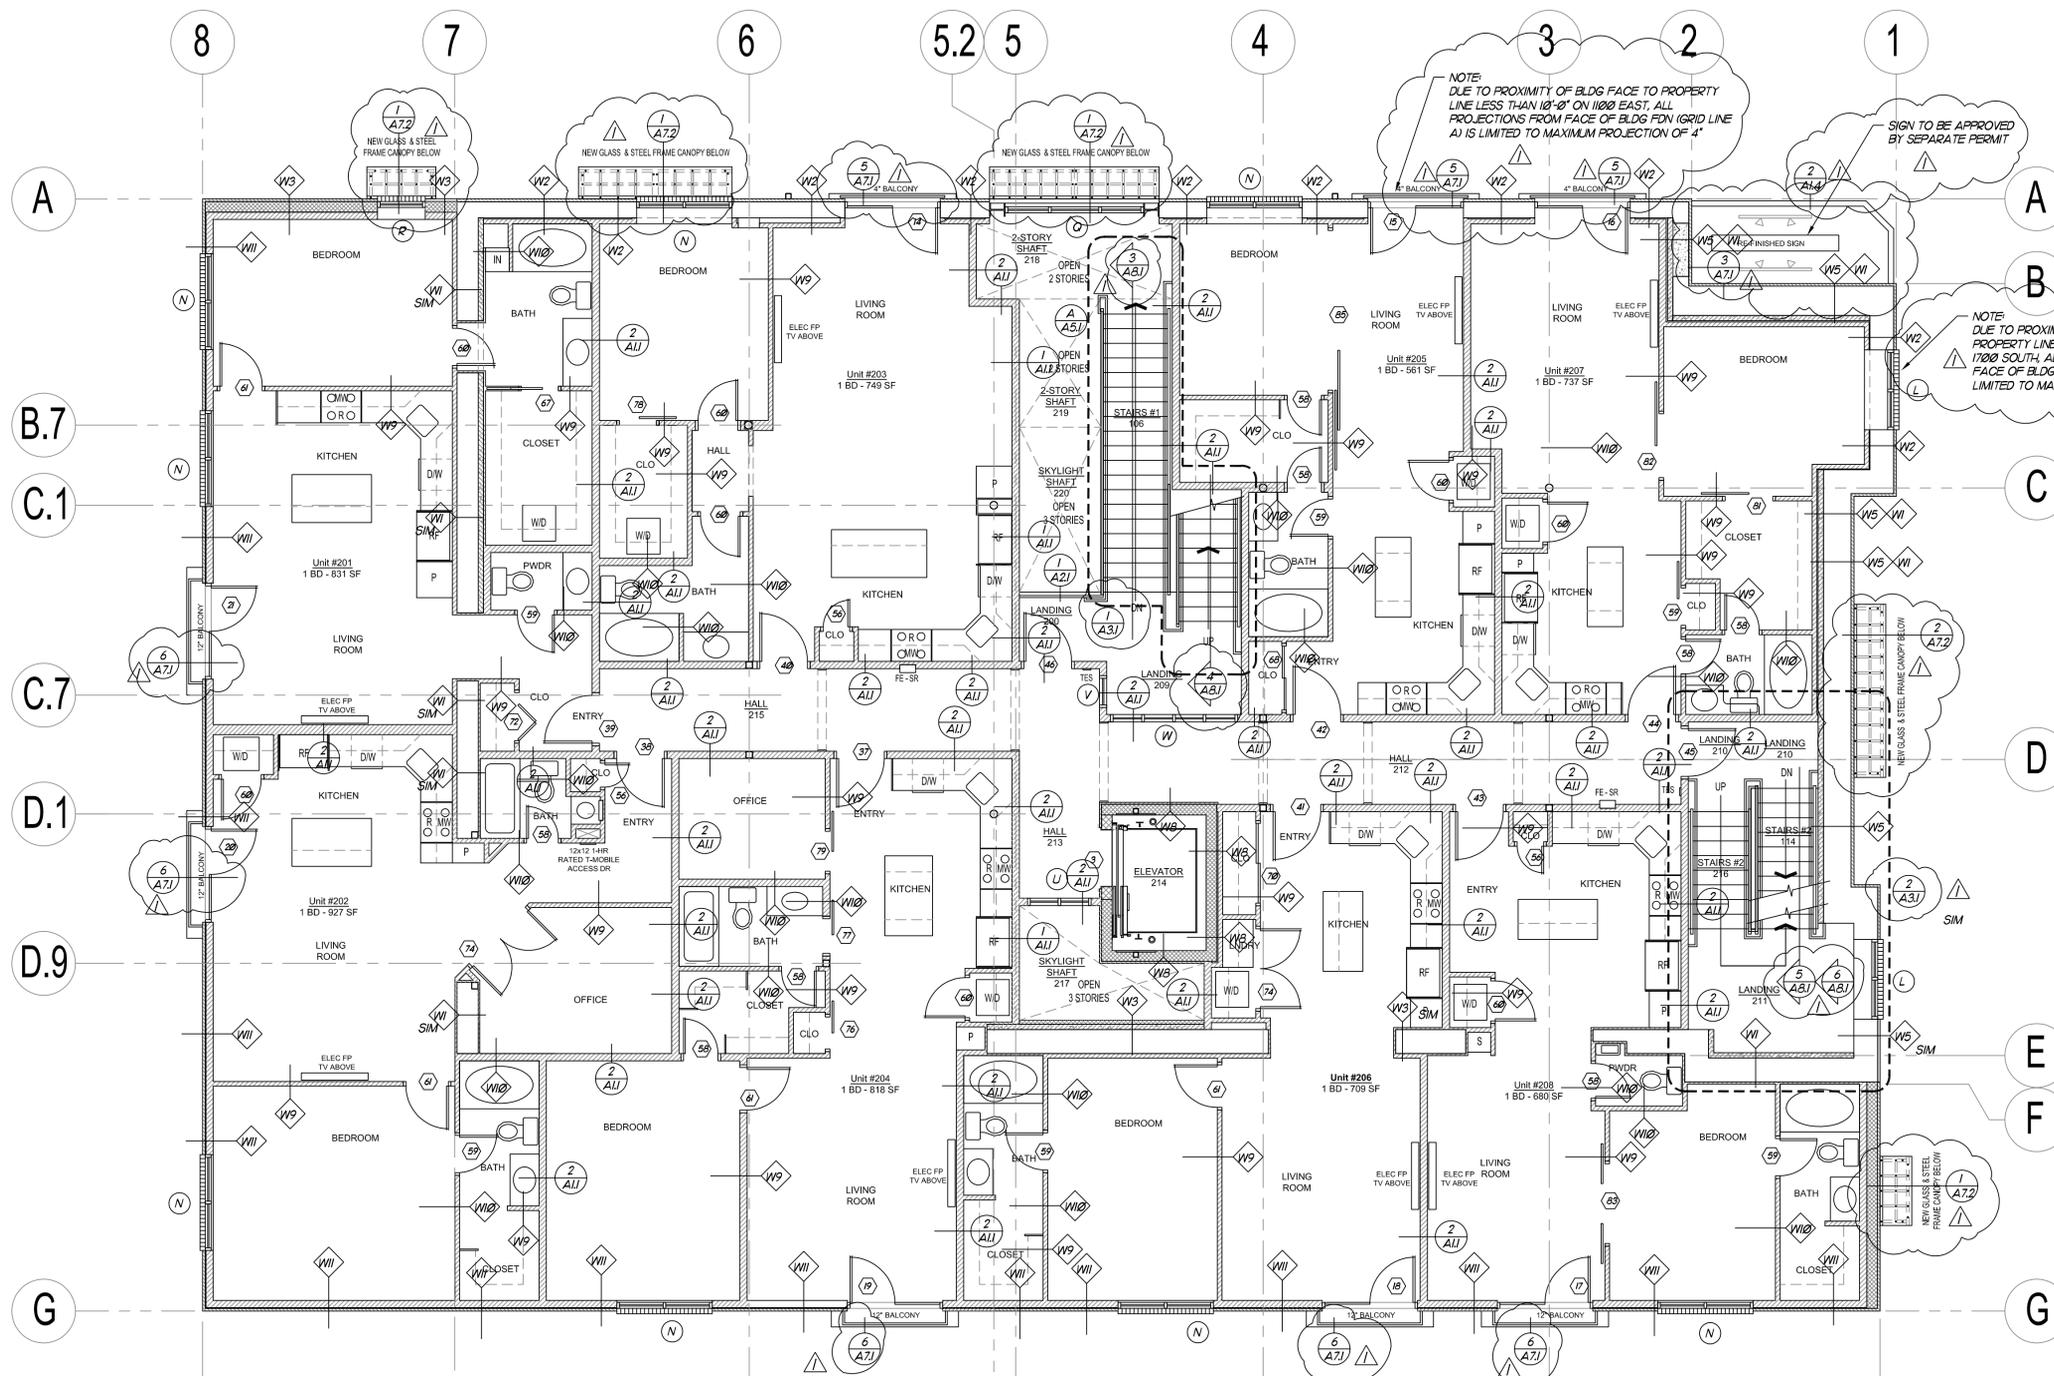





2ND FLOOR PLAN

SCALE: 3/16" = 1'-0"



- NOTES:
- TES = TACTILE EXIT SIGN
 - FE SR = SEMI-RECESSED FIRE EXTINGUISHER CABINET
 - FACP = FIRE ALARM CONTROL PANEL
 - MTR OR MTRS = METER OR METERS
 - FDC = FIRE DEPARTMENT CONNECTION
 - ELEC FP = ELECTRIC FIRE PLACE
 - WIC = WALK IN CLOSET
 - CLO = CLOSET
 - P = PANTRY
 - L = LINEN CABINET
 - DW = DISHWASHER
 - WD = STACKED WASHER & DRYER
 - REF OR RF = REFRIGERATOR
 - MW = MICROWAVE
 - R = RANGE
 - DN = DOWN
 - RD = ROOF DRAIN

04-05-17 - SLC DEPT PLAN REVIEWS AND OWNER VALLE ENGINEERING CORRECTIONS

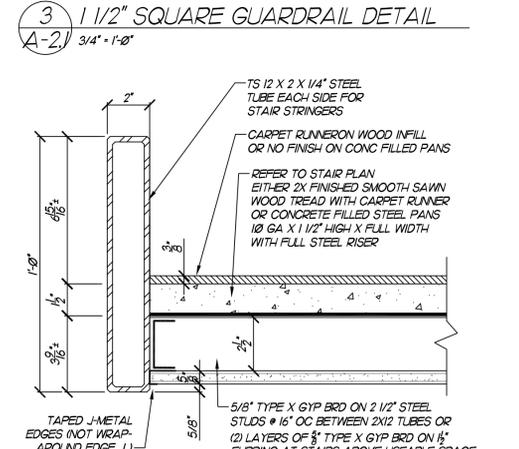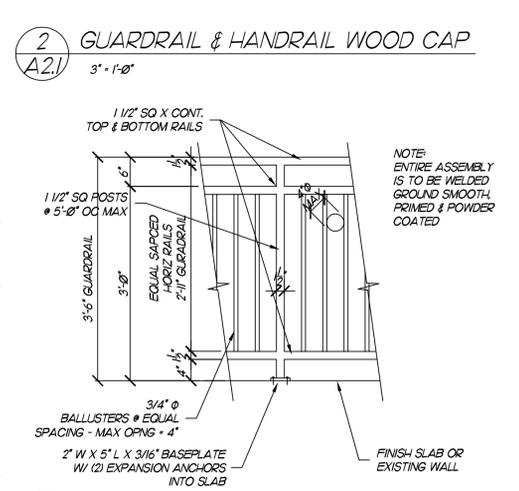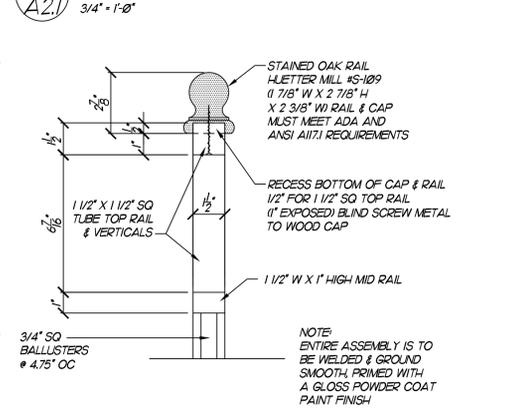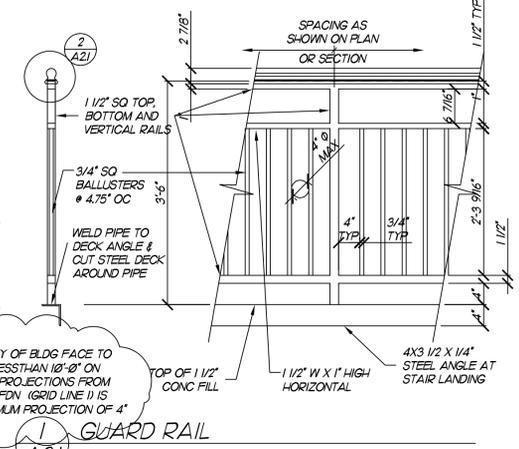



James B. Glascock, Architect P.C.
 Architecture • Planning
 4897 Rebecca Circle
 Salt Lake City, Utah 84117
 801 - 272 - 5133 e-mail: glascock@mtcon.net



ALL RIGHTS RESERVED. JAMES B. GLASCOCK, ARCHITECT. COPYRIGHT
 This drawing is classified as part of an intellectual collection of work. Under the 1976 copyright act, it is an exclusive original work of authorship. None of the mechanical, graphic or technical sheets or drawings depicted on this sheet may be reproduced, stored in a retrieval system, or transmitted in any form or by any means electronic, mechanical or otherwise without the express prior written permission of the architect.


Project 15-027
 REMODEL FOR:
 SALT LAKE COSTUME BUILDING
 1700 SOUTH 1100 EAST
 SALT LAKE CITY, UTAH

Date 12/01/16
 Revisions
 A-21

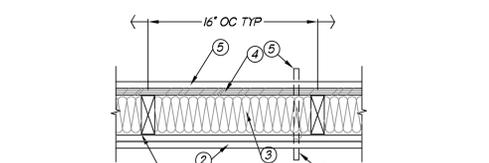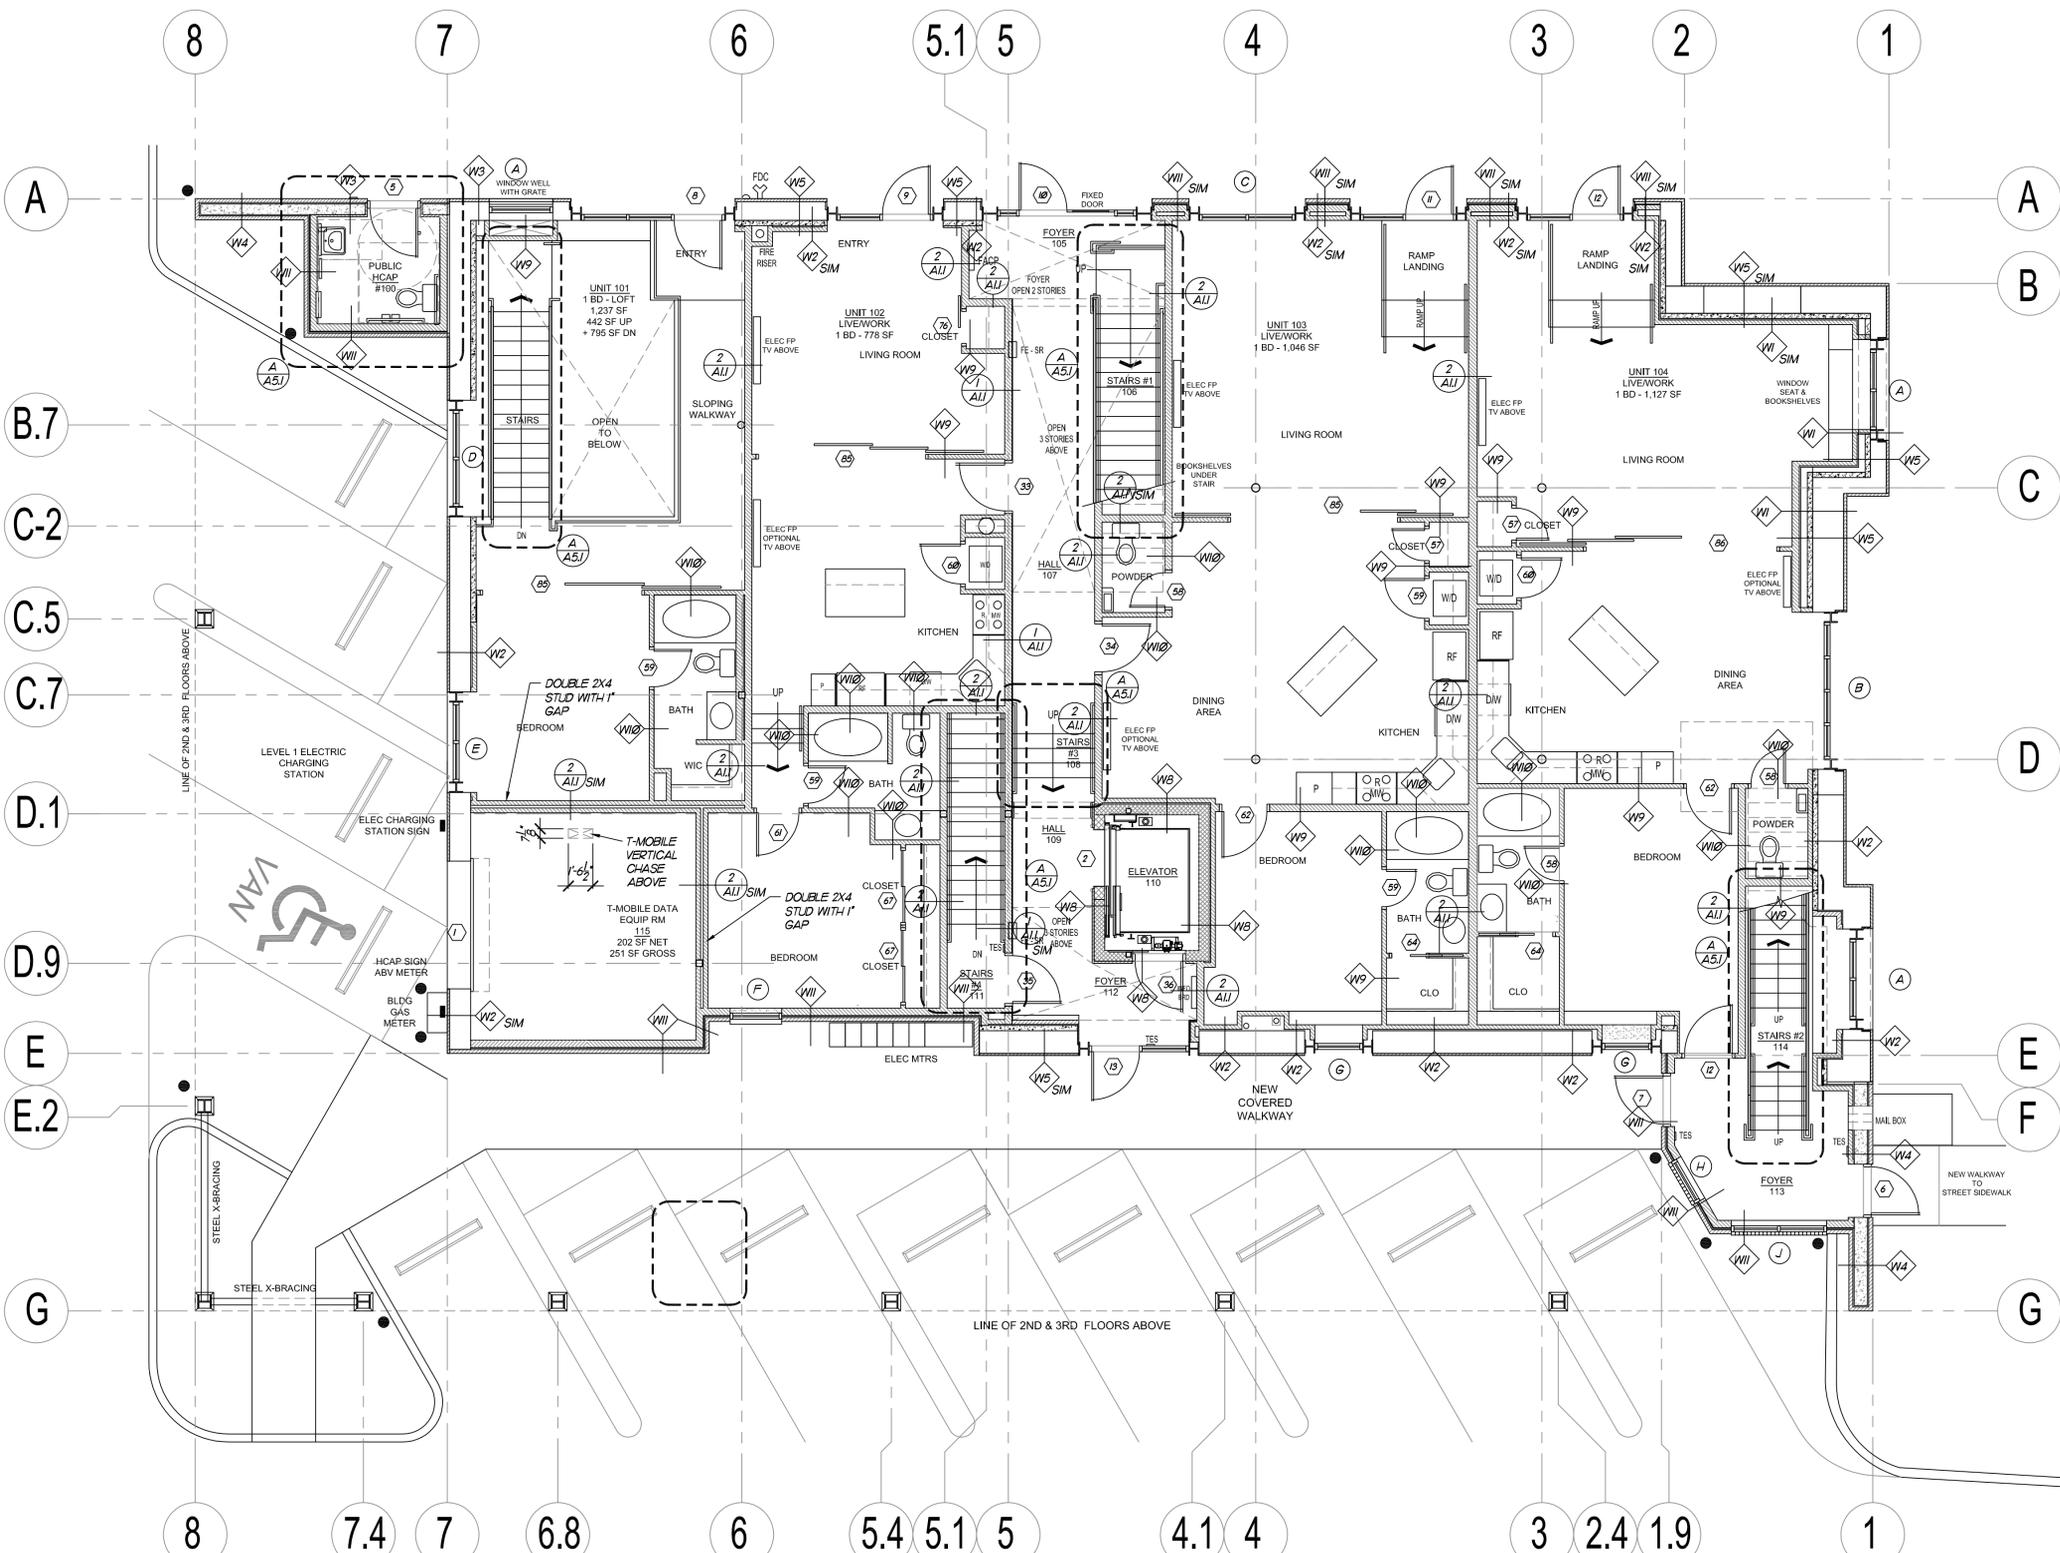

- ONE-HOUR RATED EXTERIOR WALL ASSEMBLY - SOURCE: U.L. DESIGN #U-327 - STC SOUND RATING MIN OF 54 PER SOUND TEST: RAL-TLH-174
- 2x6's @ 16" O.C. BRACED AT MID-HEIGHT AND EFFECTIVELY FIRESTOPPED AT TOP & BOTTOM. ON INTERIOR WALL SIDE INSTALL ONE LAYER OF 5/8" THICK TYPE X GYPSUM WALLBOARD WITH PARALLEL TO RESILIENT CHANNELS 24" OC WITH 1" TYPE S DRYWALL SCREWS AT EDGES AND "CENTER ROW" 12" OC. END JOINTS BACK-BLOCKED WITH RC-1 RESILIENT CHANNELS. RESILIENT CHANNELS ATTACHED AT RIGHT ANGLES TO WOOD STUDS @ 16" OC WITH 1/2" TYPE S DRYWALL SCREWS.
 - 3" MINERAL SOUND FIBER 230 OR 23 PCF IN STUD SPACE X FULL HEIGHT OF WALL. PRESSURE FIT IN CAVITY. SOUND TESTED WITH OPEN FACE OF 20 MINERAL FIBER BLANKETS TOWARDS RESILIENT CHANNEL SIDE OF WALL & ON SAME SIDE AS RC-1 CHANNEL.
 - ON OPPOSITE WALL SIDE WALL, INSTALL 1/2" WOOD SHEARWALL SHEATHING AS INDICATED ON STRUCTURAL PLANS.
 - OVER WOOD SHEATHING, INSTALL ONE LAYER OF 5/8" TYPE X GYPSUM WALLBOARD APPLIED AT RIGHT ANGLES TO STUDS WITH 1/2" TYPE W DRYWALL SCREWS 12" O.C. STAGGER VERTICAL JOINTS 48" OC EACH SIDE.
 - SEAL EDGE OF ALL HVAC, PLUMBING OR ELECTRICAL PENETRATIONS THROUGH WALL ASSEMBLY WITH 1-HR RATED U.L. TESTED AND APPROVED SEALANT. SEE SPECS.

1 1 HR RATED WALL WITH SHEATHING
NO SCALE

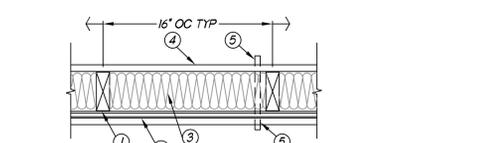


- ONE-HOUR RATED EXTERIOR WALL ASSEMBLY - SOURCE: U.L. DESIGN #U-327 - STC SOUND RATING MIN OF 54 PER SOUND TEST: RAL-TLH-174
- 2x6's @ 16" O.C. BRACED AT MID-HEIGHT AND EFFECTIVELY FIRESTOPPED AT TOP & BOTTOM. ON INTERIOR WALL SIDE, INSTALL ONE LAYER OF 5/8" THICK TYPE X GYPSUM WALLBOARD WITH PARALLEL TO RESILIENT CHANNELS 24" OC WITH 1" TYPE S DRYWALL SCREWS AT EDGES AND "CENTER ROW" 12" OC. END JOINTS BACK-BLOCKED WITH RC-1 RESILIENT CHANNELS. RESILIENT CHANNELS ATTACHED AT RIGHT ANGLES TO WOOD STUDS @ 16" OC WITH 1/2" TYPE S DRYWALL SCREWS.
 - 3" MINERAL SOUND FIBER 230 OR 23 PCF IN STUD SPACE X FULL HEIGHT OF WALL. PRESSURE FIT IN CAVITY. SOUND TESTED WITH OPEN FACE OF 20 MINERAL FIBER BLANKETS TOWARDS RESILIENT CHANNEL SIDE OF WALL AND ON SAME SIDE AS RC-1 CHANNELS.
 - ON OPPOSITE WALL OF RESILIENT CHANNELS, INSTALL ONE LAYER OF 5/8" TYPE X GYPSUM WALLBOARD APPLIED AT RIGHT ANGLES TO STUDS WITH 1/4" TYPE W DRYWALL SCREWS 12" O.C. STAGGER VERTICAL JOINTS 48" OC EACH SIDE.
 - SEAL EDGE OF ALL HVAC, PLUMBING OR ELECTRICAL PENETRATIONS THROUGH WALL ASSEMBLY WITH 1-HR RATED U.L. TESTED AND APPROVED SEALANT. SEE SPECS.

2 1 HR RATED INTERIOR COMMON WALL
NO SCALE

- ONE HOUR RATED FLOOR ASSEMBLY - SOURCE: U.L. DESIGN NO. L5161 AND U.S.G. FIRE-RESISTANT ASSEMBLIES HANDBOOK - STC SOUND RATING MIN OF 54 PER SOUND TEST: USS 74874

- FINISH FLOOR TOPPING MIXTURE: 1 1/2" LIGHTWEIGHT CONCRETE COMPRESSIVE STRENGTH + 3000 PSI MINIMUM.
- FLOOR MAT MATERIAL LOOSE LAID OVER THE SUBFLOOR, EQUAL TO MAXXON CORP. - TYPE ACOUST-MAT II, ACOUST-MAT I, ACOUST-MAT I, SLEEPOODING - MIN 23/32 IN THICK TEG WOOD STRUCTURAL PANELS, MIN GRADE "SINGLE-FLOOR", FACE GRAIN OF PLYWOOD OR STRENGTH AXIS OF PANELS TO BE PERPENDICULAR TO THE FLOOR JOISTS WITH END JOINTS STAGGERED 4 FT. PANELS SECURED TO JOISTS WITH CONSTRUCTION ADHESIVE AND NO. 60 RINGED SHANK NAILS SPACED 12 IN. OC ALONG EACH JOIST. STAPLES HAVING EQUAL OR GREATER WITHDRAWAL AND LATERAL RESISTANCE STRENGTH MAY BE SUBSTITUTED FOR THE 60 NAILS. REFER TO STRUCTURAL PLANS FOR ADDITIONAL FLOOR SHEATHING NAILING.
- WOOD JOISTS - MIN 2 X 10 SPACED 16 IN. OC AND EFFECTIVELY FIREBLOCKED PER CODE. PROVIDE CROSS BRIDGING - MIN 1 BY 3 IN. OR MIN 2 X 10 SOLID BLOCKING, IN-LEAF OF CROSS BRIDGING, HORIZONTAL BRIDGING IN THE SAME JOIST BAY AS CEILING DAMPER. WHEN CEILING DAMPER IS EMPLOYED, WOOD 2 X 4 SECURED BETWEEN JOISTS WITH NAILS.
- CEILING DAMPERS - MAX NOM ARE REA SHALL BE 198 SQ IN. MAX RECTANGULAR SIZE SHALL BE 12 IN. WIDE BY 16-1/2 IN. LONG. MAX HEIGHT OF DAMPER SHALL BE 8-3/4 IN. AGGREGATE DAMPER OPENINGS SHALL NOT EXCEED 99 SQ IN. PER 100 SQ FT. OF CEILING AREA. DAMPER IS TO BE INSTALLED IN ACCORDANCE WITH THE MANUFACTURERS INSTALLATION INSTRUCTIONS PROVIDED WITH THE DAMPER. A STEEL GRILLE SHALL BE INSTALLED IN ACCORDANCE WITH INSTALLATION INSTRUCTIONS.
- SOUND BATTS AND BLANKETS - NOM 48 X 16 X 3 IN. THICKNESS OF GLASS FIBER BATTS SECURED TO JOISTS ON BOTH SIDES WITH STAPLES SPACED 12 IN. OC.
- INSTALL RC-1 RESILIENT CHANNELS FORMED FROM NO. 25 MSG GALV. STEEL AND SHAPED AS SHOWN BELOW, RC-1 TO BE SPACED 24 IN. OC PERPENDICULAR TO JOISTS, CHANNELS OVERLAPPED 1/2 IN. AT ENDS AND SECURED TO EACH JOIST WITH ONE 1/4 IN. LONG NO. 7 TYPE S BULGE HEAD SCREW. ADDITIONAL RESILIENT CHANNELS POSITIONED SO AS TO COINCIDE WITH END JOINTS OF GYPSUM BOARD. ADDITIONAL CHANNELS SHALL EXTEND MIN 3 IN. BEYOND EACH SIDE EDGE OF BRD. TWO LAYERS OF NOM 5/8 IN. THICK 4 FT WIDE GYPSUM BOARD, INSTALLED WITH LONG DIMENSION PERPENDICULAR TO JOISTS ON TOP OF THE FLOOR MAT MATERIAL. GYPSUM BOARD SECURED TO EACH OTHER WITH 1 IN. LONG NO. 6 TYPE G BULGE HEAD STEEL SCREWS SPACED 12 IN. OC AND LOCATED A MIN OF 1/2 IN. FROM SIDE AND END JOINTS. THE JOINTS OF THE GYPSUM BOARD ARE TO BE STAGGERED A MINIMUM OF 12 INCHES IN BETWEEN LAYERS AND FROM THE JOINTS OF THE SUBFLOOR.
- SEAL ALL EDGES OF AN HVAC, PLUMBING, ELECTRICAL PENETRATIONS THROUGH THIS ASSEMBLY WITH 1 HOUR RATED, U.L. TESTED AND APPROVED SEALANT. REFER TO SPECIFICATIONS.
- BASE LAYER JOINTS DO NOT NEED TO BE FINISHED BUT FIRE-TAPED ONLY. SECOND LAYER OF GYPSUM BOARD TO HAVE PAPER TAPE EMBEDDED IN GEMETICIOUS COMPOUND OVER JOINTS & EXPOSED SCREW HEADS COVERED WITH COMPOUND WITH EDGES OF COMPOUND TEXTURED & SANDED OUT.

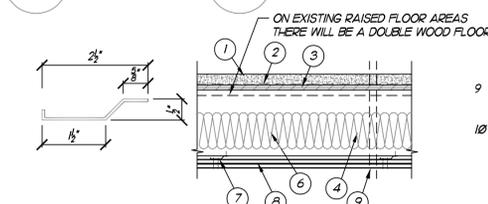

3 1 HR RATED FLOOR ASSEMBLY
1" = 1'-0"

- NOTES:
TES = TACTILE EXIT SIGN
SFE = SEMI-RECESSED FIRE EXTINGUISHER CABINET
FACP = FIRE ALARM CONTROL PANEL
MTR OR MTRS = METER OR METERS
FDC = FIRE DEPARTMENT CONNECTION
ELEC FP = ELECTRIC FIRE PLACE
WIC = WALK IN CLOSET
CLO = CLOSET
P = PANTRY
L = LINEN CABINET
DW = DISHWASHER
W/D = STACKED WASHER & DRYER
REF OR RF = REFRIGERATOR
MW = MICROWAVE
R = RANGE
DN = DOWN
RD = ROOF DRAIN



MAIN FLOOR PLAN



SCALE: 3/16" = 1'-0"

James B. Glascock, Architect P.C.
Architecture • Planning
4897 Rebecca Circle
Salt Lake City, Utah 84117
801 - 272 - 5133 e-mail: jglascock@mtcon.net



ALL RIGHTS RESERVED. JAMES B. GLASCOCK, ARCHITECT. COPYRIGHT
This drawing is submitted as part of an architectural contract of record. Under the 1978 copyright act, it is an exclusive original work of authorship. None of the mechanical, graphic or technical sheets or drawings depicted on this sheet may be reproduced, stored in a retrieval system, or transmitted in any form or by any means electronic, mechanical, or otherwise without the express prior written permission of the architect.

Date	12/01/16	Project	15-027	REMODEL FOR: SALT LAKE COSTUME BUILDING 1701 SOUTH 1100 EAST SALT LAKE CITY, UTAH
Revisions				
				A-1/1

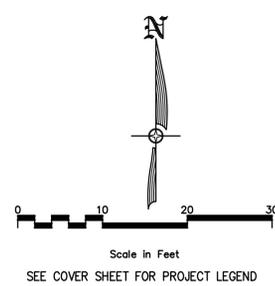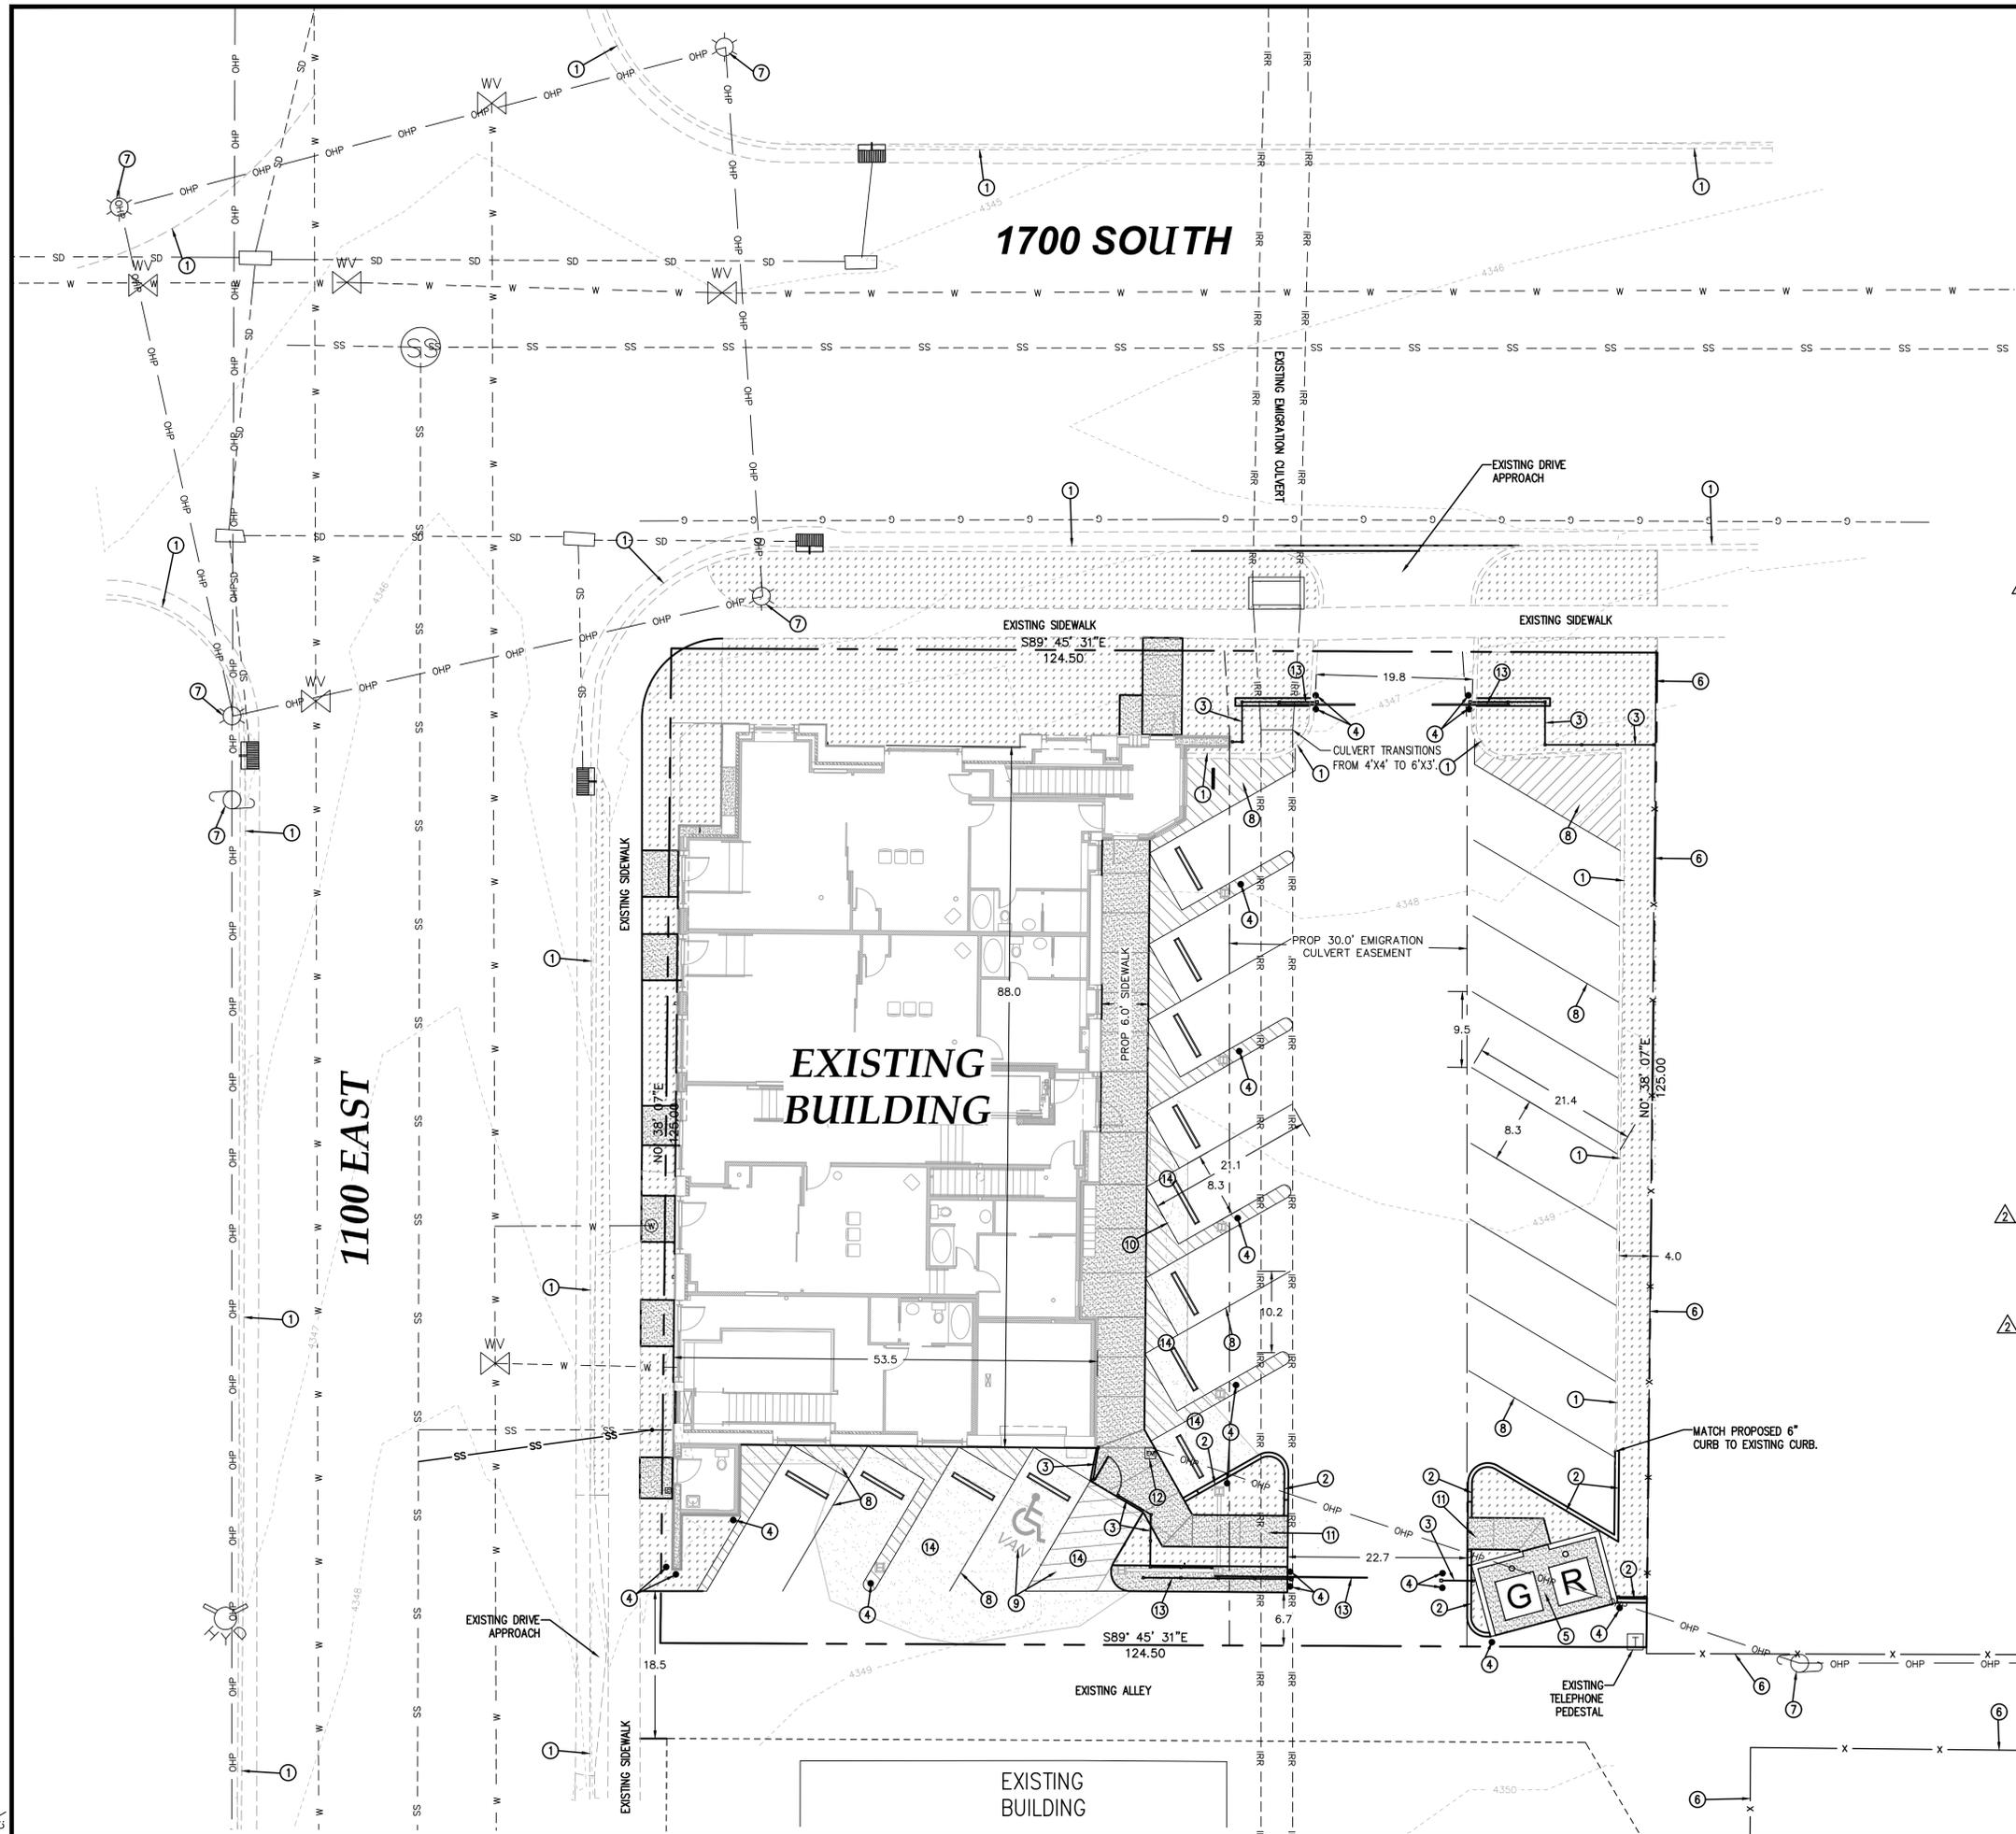

- SITE PLAN NOTES:**
- ① EXISTING CURB & GUTTER
 - ② PROPOSED 6" CURB. SEE DETAIL 2/C4.
 - ③ PROPOSED FENCE. SEE ARCHITECTURAL DRAWINGS FOR DETAILS.
 - ④ PROPOSED BOLLARD. SEE ARCHITECTURAL DRAWINGS FOR DETAILS.
 - ⑤ PROPOSED TRASH ENCLOSURE. SEE ARCHITECTURAL DRAWINGS FOR DETAILS.
 - ⑥ EXISTING FENCE.
 - ⑦ EXISTING POWER POLE.
 - ⑧ PROPOSED PARKING LOT STRIPING TO BE DONE AFTER ASPHALT OVERLAY.
 - ⑨ PROPOSED HANDICAP STALLS SHALL HAVE SLOPES OF LESS THAN 2% IN ALL DIRECTIONS.
 - ⑩ EXISTING GAS METER AND LINE TO BE RELOCATED.
 - ⑪ PROPOSED CURB OPENING SIDEWALK. SEE DETAIL 4/C4. DETECTIBLE WARNING OF SCORED CONCRETE OR TRUNCATED DOME TO BE PROVIDED PER CITY FIELD INSPECTOR DIRECTION.
 - ⑫ EXISTING ELECTRIC METER TO BE RELOCATED.
 - ⑬ PROPOSED GATE. SEE ARCHITECTURAL DRAWINGS FOR DETAILS.
 - ⑭ PROPOSED ASPHALT PAVEMENT TO MATCH EXISTING ASPHALT PAVEMENT SECTION.

ELECTRIC GATES NOTE:
UPON COMPLETION THE SECURITY CODE FOR THE ELECTRONIC GATES TO BE PROVIDED TO SALT LAKE CITY PUBLIC UTILITIES.

ALL WORK DONE WITHIN THE PUBLIC WAY SHALL BE DONE BY A LICENSED, BONDED AND INSURED CONTRACTOR WHO SHALL FIRST OBTAIN A PUBLIC WAY PERMIT. A TRAFFIC CONTROL PERMIT MAY ALSO BE REQUIRED, CONTRACTOR IS RESPONSIBLE FOR OBTAINING ALL PERMITS.


NO	REVISIONS	BY	DATE
1	COMMENTS		
2	COMMENTS		

CIR ENGINEERING, L.L.C.
3032 SOUTH 1030 WEST, SUITE 202
SLC, Utah 84119 - 801-949-6296

SALT LAKE COSTUME
1701 SOUTH 1100 EAST, SLC, UTAH
SITE PLAN




SHEET NO. **C1**
PROJECT ID: H1003-01
DATE: 11/04/16
FILE NAME: PRJ-SHC
SCALE: 1"=10'

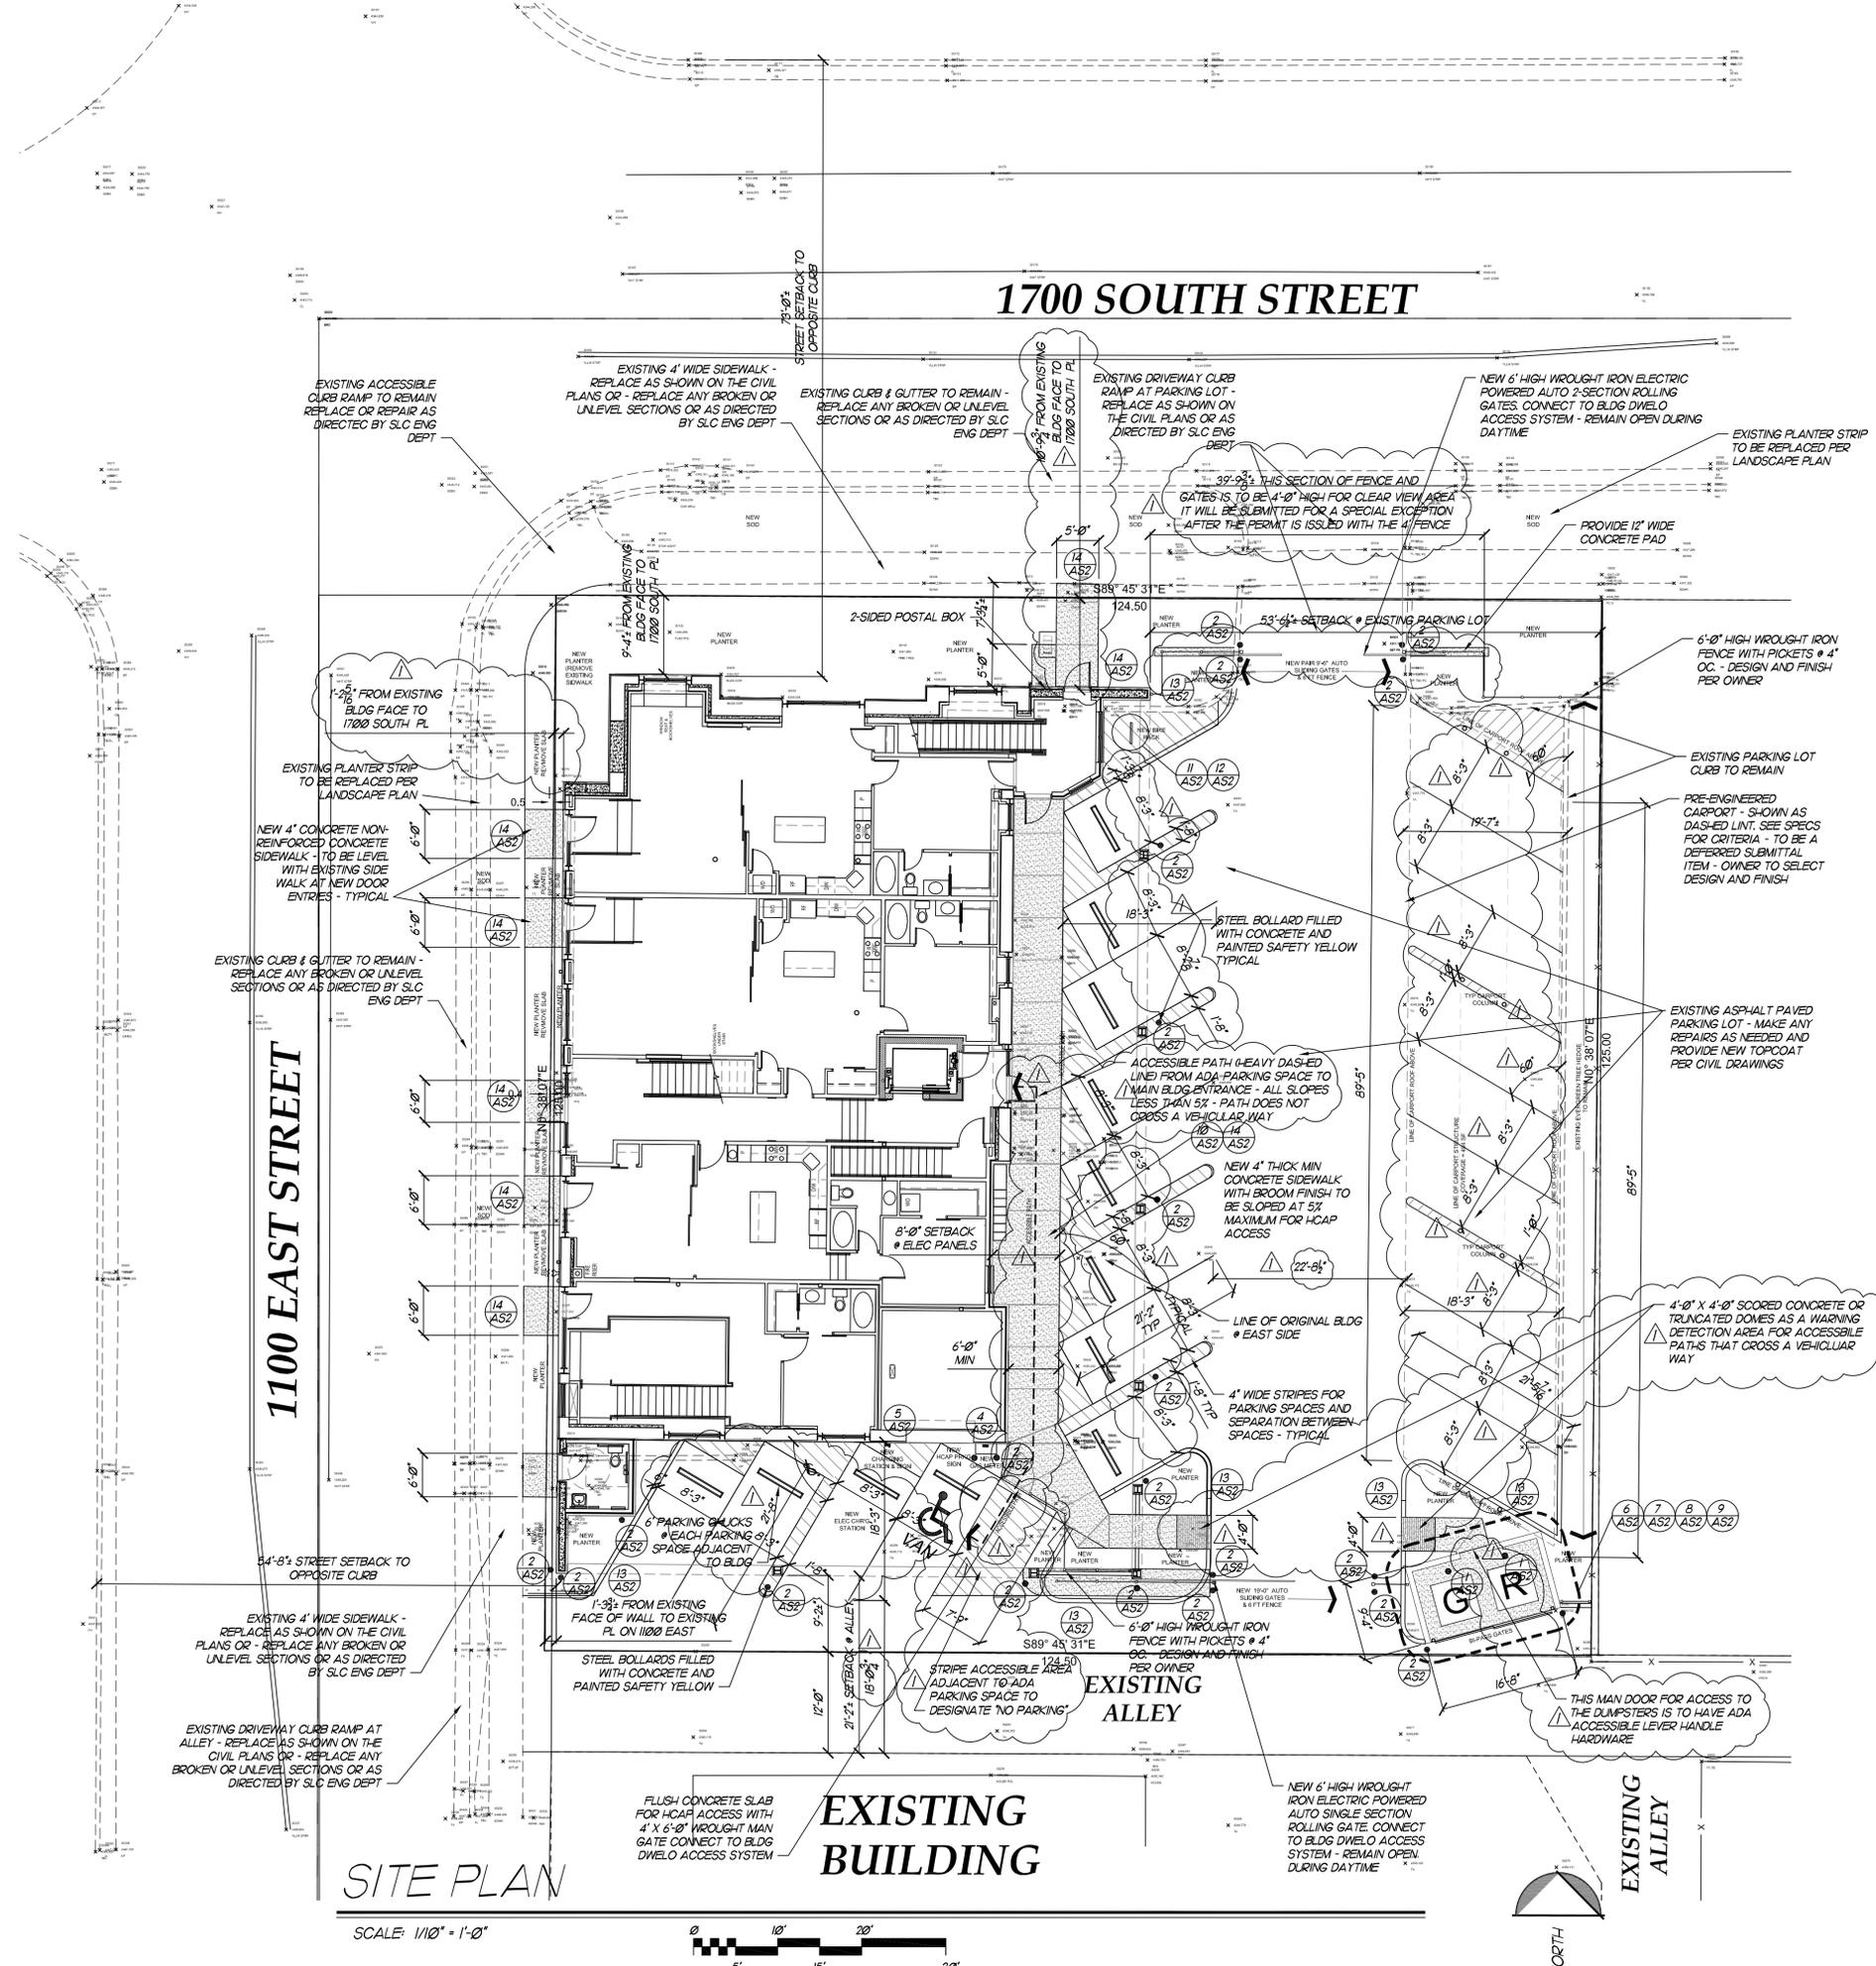

SITE PLAN

SCALE: 1/10" = 1'-0"

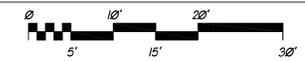

BUILDING SF SUMMARY

EXISTING BLDG	
BASEMENT (1/2 APT UNIT 1002)	724 GROSS SF
BASEMENT PART OF UNIT 1100 LOFT	1,168 GROSS SF
STORAGE AND MECHANICAL	1,884 GROSS SF
TOTAL BASEMENT	3,776 GROSS SF
MAIN FLOOR (3 1/2 APT - 1 BEDROOM UNITS)	4,824 GROSS SF (BLDG FOOTPRINT)
2ND FLOOR (8 - 1 BDRM APARTMENT UNITS)	7,230 GROSS SF
3RD FLOOR (5 - 1 BDRM APARTMENT UNITS)	7,230 GROSS SF
TOTAL 3RD FLOOR	14,460 GROSS SF
TOTAL BLDG GROSS SF	18,236 GROSS SF
TOTAL BLDG NET USEABLE (APARTMENT) SF	16,270 GROSS SF
	19 APARTMENTS
ORIGINAL BLDG SF BEFORE PARTIAL DEMOLITION	
PARTIAL BASEMENT	2,122 GROSS SF
MAIN FLOOR + MEZZANINE	4,968 GROSS SF
2ND FLOOR	4,968 GROSS SF
3RD FLOOR	4,968 GROSS SF
TOTAL ORIGINAL BLDG	17,026 GROSS SF
% OF ORIGINAL BLDG SF TO NEW BLDG SF	60%
ORIGINAL PERIMETER LF	309.71 LF
ORIGINAL PERIMETER LF MAINTAINED	260.19 LF
% OF REMAINING LF TO ORIGINAL BLDG LF	84%

SITE SUMMARY


SITE INFORMATION		1701 SOUTH 1100 EAST	
ADDRESS	1701 SOUTH 1100 EAST		
PARCEL #	16-17-259-020-02000		
EXISTING ZONING	RB		
SITE USAGE BREAKDOWN			
BUILDING MAIN FOOTPRINT (INCLUDES 2ND & 3RD FLOORS ABOVE)	7,230 SF	46.5%	
CARPPOOL STRUCTURAL COVERAGE FOOTPRINT	490 SF	3.1%	
TOTAL ACTUAL BUILDING FOOTPRINT COVERAGE	7,720 SF	49.6%	
ALLOWABLE - 50% - PROJECT MEETS CODE			
LANDSCAPING	1,920 SF	12.3%	
SEE LANDSCAPE PLAN L-11 FOR SF BREAKDOWN FOR 20% ONSITE & OFF SITE LANDSCAPING			
PAVEMENT/SLABS/WALKS	5,922 SF	38.1%	
TOTAL SITE (0.36 AC)	15,562 SF	100.0%	

SITE PARKING SUMMARY

EXISTING BUILDING		
MAIN APARTMENTS + BASEMENT LOFT SPACE	4 APARTMENTS (ALL 1 BEDROOM)	
CONSIDERED WORK/LIVE UNITS	6 APARTMENTS (ALL 1-BEDROOM)	
2ND FLOOR APARTMENTS	8 APARTMENTS	
3RD FLOOR APARTMENTS	(2 - 2 BEDROOM + 6 1-BEDROOM)	
TOTAL BUILDING REQUIRED PARKING		4 (1) BEDRMS LIVE /WORK + 4 SPACES
TOTAL REQUIRED		12 (1) BEDROOMS - 12 SPACES
TOTAL SPACES PROVIDED		4 (2) BEDROOMS - 4 SPACES
		20 SPACES REQUIRED
		21 SPACES PROVIDED
ACCESSIBLE SPACES REQUIRED		1 ACCESSIBLE SPACE REQUIRED
CHAPTER 21A.44.0200 - 11-25 SPACES		1 ACCESSIBLE SPACE PROVIDED
BIKE PARKING REQUIRED		1 BICYCLE PARKING REQUIRED
5% OF REQUIRED PARKING - 21 X 5%		1 BICYCLE PARKING PROVIDED
1 NEW CITY STD BIKE RACKS		
OTHER SPACES PROVIDED ON SITE		1 LEVEL 1 ELECTRICAL VEHICLE WITH SIGN AND RE-CHARGE STATION PROVIDED
INTERIOR PARKING LOT LANDSCAPING REQUIRED		REFER TO LANDSCAPE CALCULATIONS ON SHEET L-11

- PLAN REVIEW NOTES FROM SALT LAKE CITY, DEPARTMENT OF COMMUNITY AND NEIGHBORHOODS**
- ALL WORK IN THE PUBLIC WAY SHALL CONFORM TO APWA 2012 STANDARD PLANS AND SPECIFICATIONS.
 - THE CURB AND GUTTER SHALL BE CONSTRUCTED AS PER APWA 205A, AND 251 OR 252.
 - ALL UTILITY TRENCH WORK IN THE PUBLIC WAY SHALL BE CONSTRUCTED AS PER APWA 255.
 - ALL SIDEWALK WORK DONE IN THE PUBLIC WAY SHALL BE CONSTRUCTED AS PER APWA 231.
 - THE DRIVE APPROACH SHALL BE CONSTRUCTED AS PER APWA 225.
 - PRIOR TO OCCUPANCY PERMIT BEING ISSUED, IT IS RECOMMENDED THAT ALL TRIP HAZARDS ON THE PUBLIC SIDEWALK BE REMOVED.
 - FOR ANY REQUIRED STREET TREES, PLEASE CONTACT TONY GLOT (801-972-7819) OR ONE OF HIS REPRESENTATIVES REGARDING THE INSTALLATION OR REMOVAL OF ANY STREET TREES.

James B. Glascock, Architect P.C.
 Architecture - Planning
 4897 Rebecca Circle
 Salt Lake City, Utah 84117
 801-272-5133 e-mail: jglascock@mtcon.net

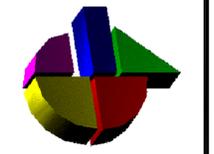

ALL RIGHTS RESERVED, JAMES B. GLASCOCK, ARCHITECT - COPYRIGHT
 This drawing is the property of James B. Glascock, Architect P.C. and shall not be reproduced or transmitted in any form or by any means electronic, mechanical, photocopying, recording, or by any information storage and retrieval system, without the prior written permission of the architect.

Project: 15-027
 REMODEL FOR:
 SALT LAKE COSTUME BUILDING
 1101 EAST 1700 SOUTH
 SALT LAKE CITY, UTAH 841

Date	Revisions
12/01/16	AS-1

104-05-17 - SLC DEPT PLAN REVIEWS AND OWNER VALUE ENGINEERING CORRECTIONS